


T.17S.,R.5W.,W.M.

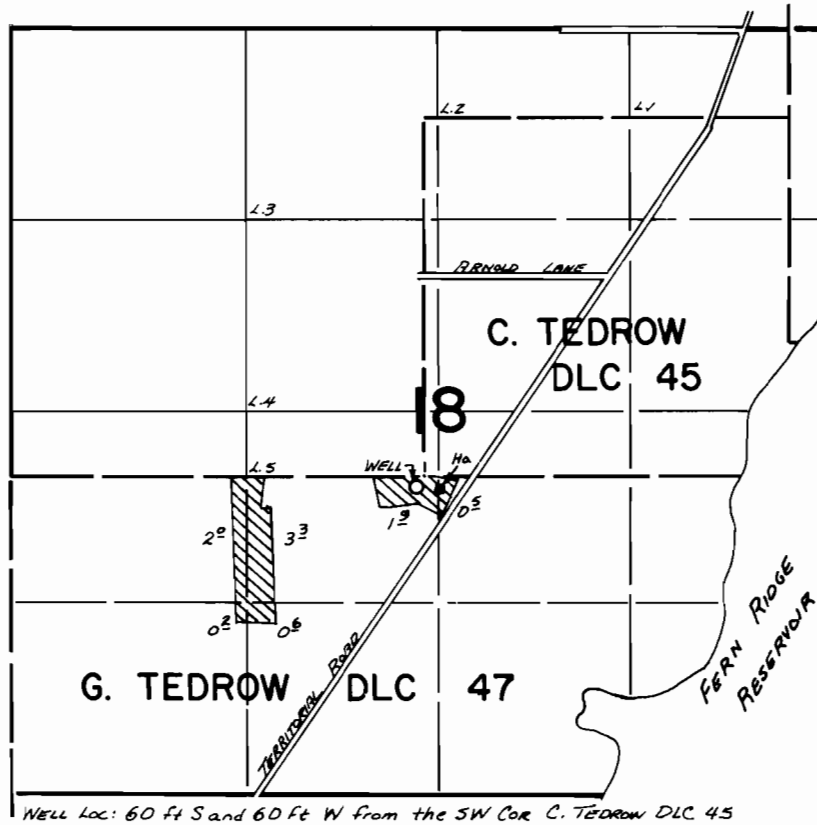

WELL Loc: 60 ft S and 60 ft W from the SW Cor C. Tedrow DLC 45

FINAL PROOF SURVEY
UNDER

Application No. G-8044 Permit No. G-7455
IN NAME OF

THOMAS W. CALMUS

Surveyed Aug. 4, 1982, by L. M. TOLL