


T. 2S., R. 1W., W.M.

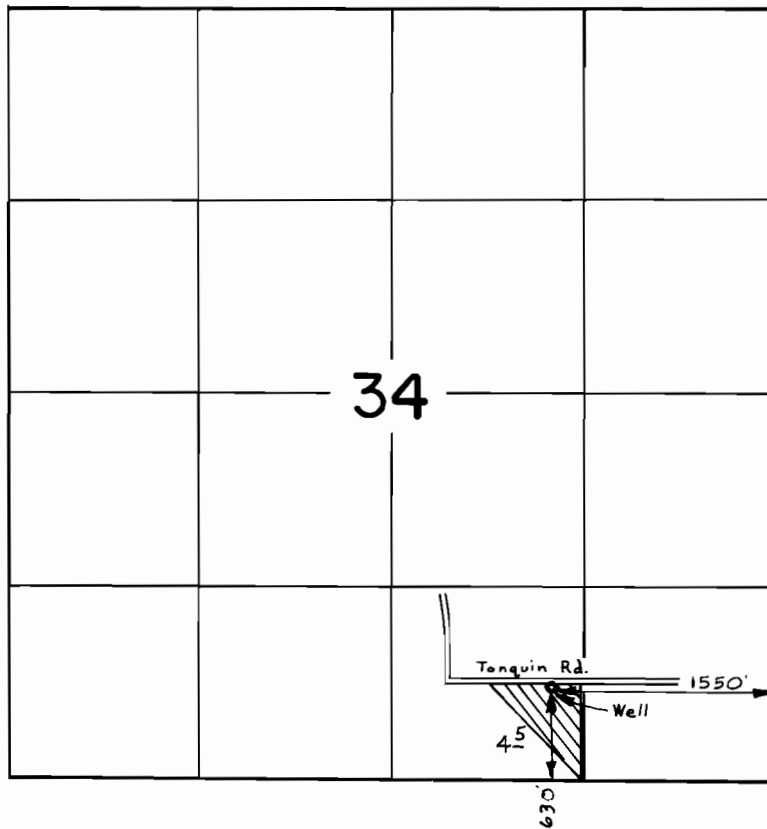

SCALE: 1" = 1320'

**FINAL PROOF SURVEY**  
UNDER

Application No. G-8095 Permit No. G-7482  
IN NAME OF

**JERRY ROSHAK**

Surveyed NOV. 10, 1983, by L. TOLL