


T.5&6S.,R.2W.,W.M.

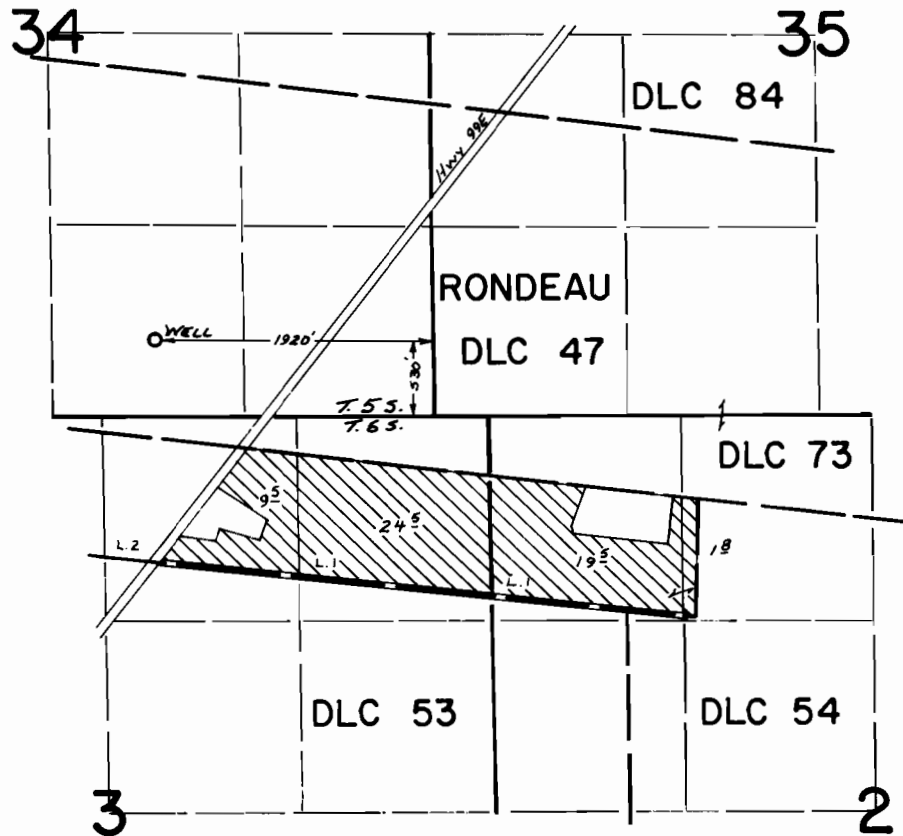

FINAL PROOF SURVEY
UNDER

Application No. G-8134 Permit No. G-7507

IN NAME OF

JAMES BUTSCH

Surveyed Oct. 13, 1981, by S. C. BROWN