


T.6S.,R.1W.,W.M.

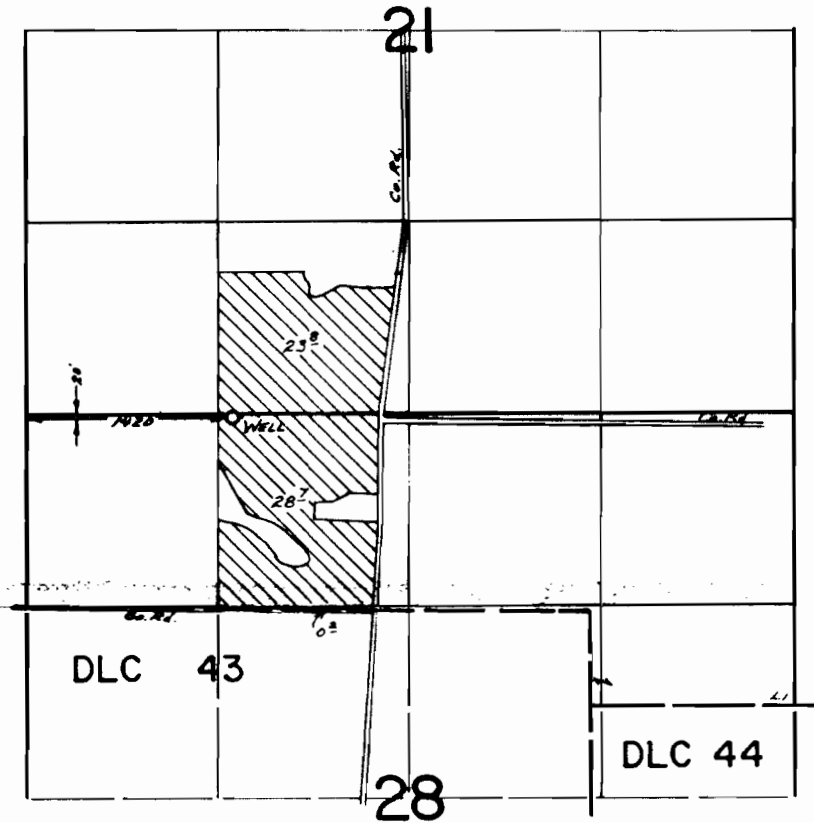

FINAL PROOF SURVEY
UNDER

Application No. G-8385 Permit No. G-7783
IN NAME OF

JAMES BUTSCH

Surveyed Sept. 8 1981, by S. C. BROWN