


T. 9S., R. 39E., W. M.

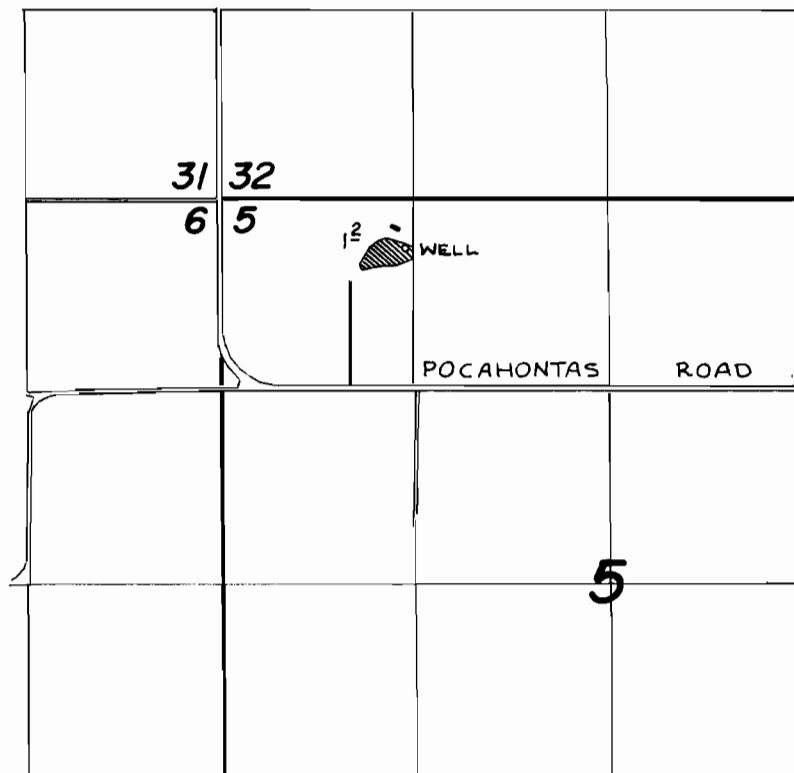

WELL IS LOCATED 340' S. AND 1270' E. FROM THE
NW. CORNER OF SECTION 5.

FINAL PROOF SURVEY
UNDER

Application No. G:8124. Permit No. G:7550...
IN NAME OF

.....LEONARD OSTER.....

Surveyed 7-21..... 1983, by U.S. Church.....