


Application No. G-8087
 Permit No. G 7580

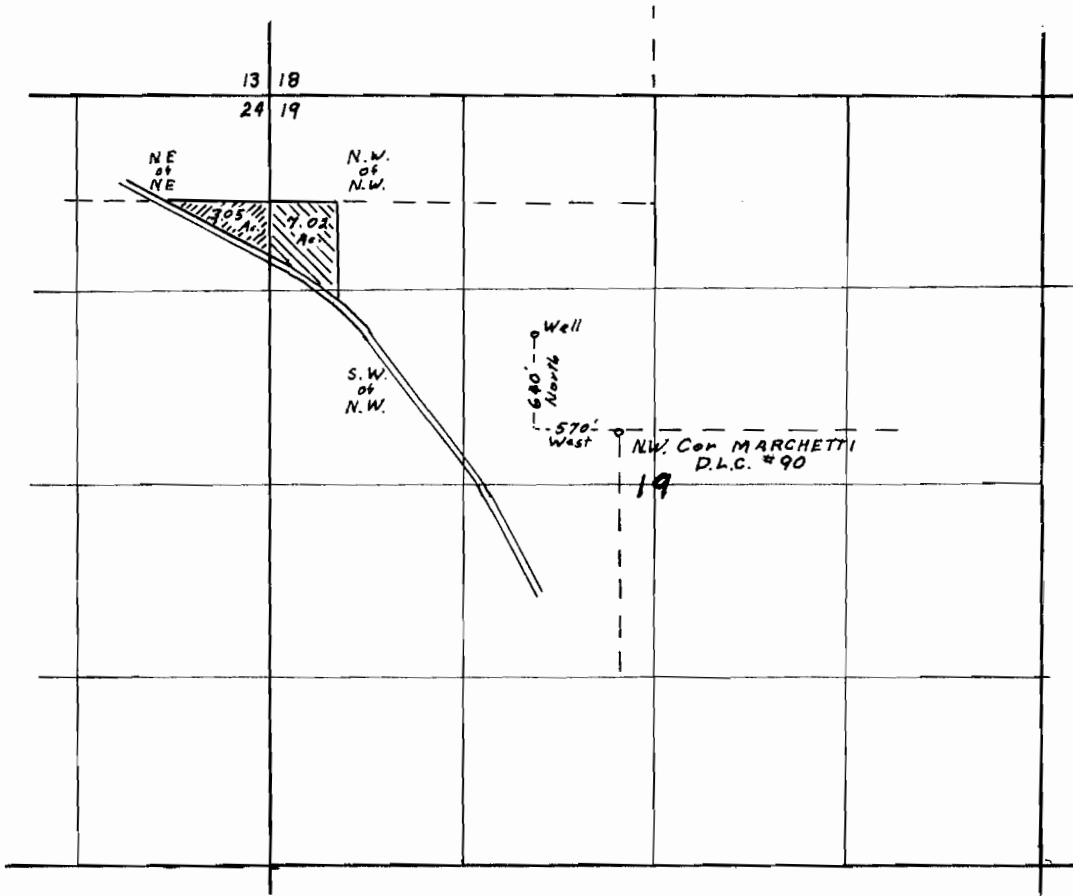

MAP FOR
 COLEMAN FARMS INC.
 Sec. 19 T. 5 S R 2 W.W.M.
 Sec. 24 T. 5 S R 3 W.W.M.
 MARION Co. OR
 Scale 1" = 20 chs
 Feb. 24/77



RECEIVED

MARION COUNTY CLERK
 MARION, OREGON

[Faint, illegible handwritten notes or signatures]