T.7S.,R.5W.,W.M.

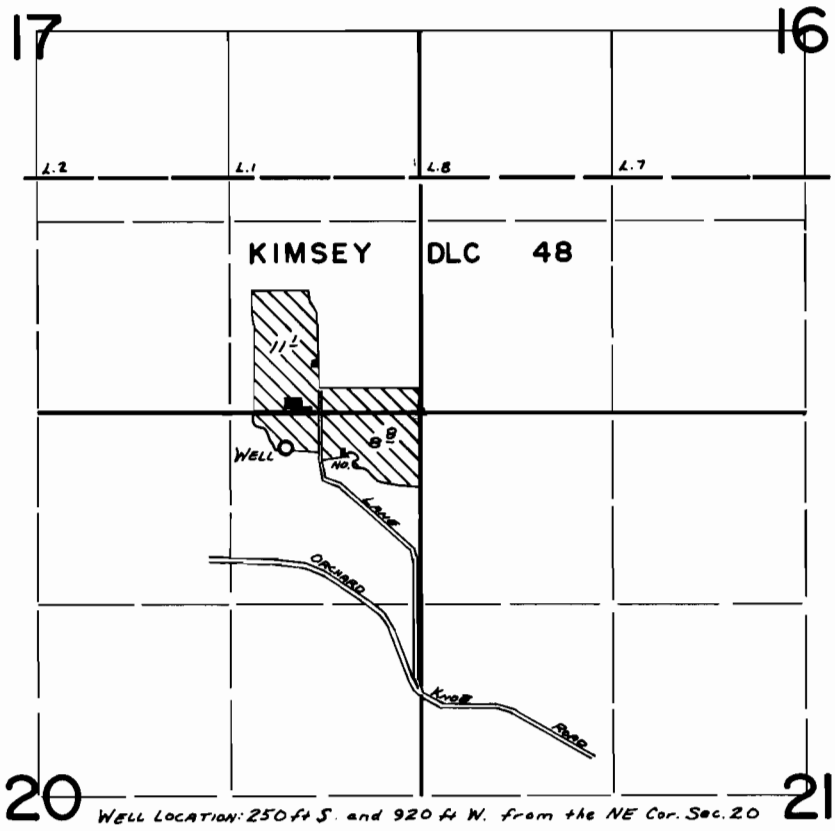

FINAL PROOF SURVEY

UNDER

Application No. G-8215 Permit No. G-7585

IN NAME OF

PAUL E. DICKERSON

Surveyed Oct. 14 19 81, by L. TOLL

DFP-ILL-10