


T.2N.,R.10E.,W.M.

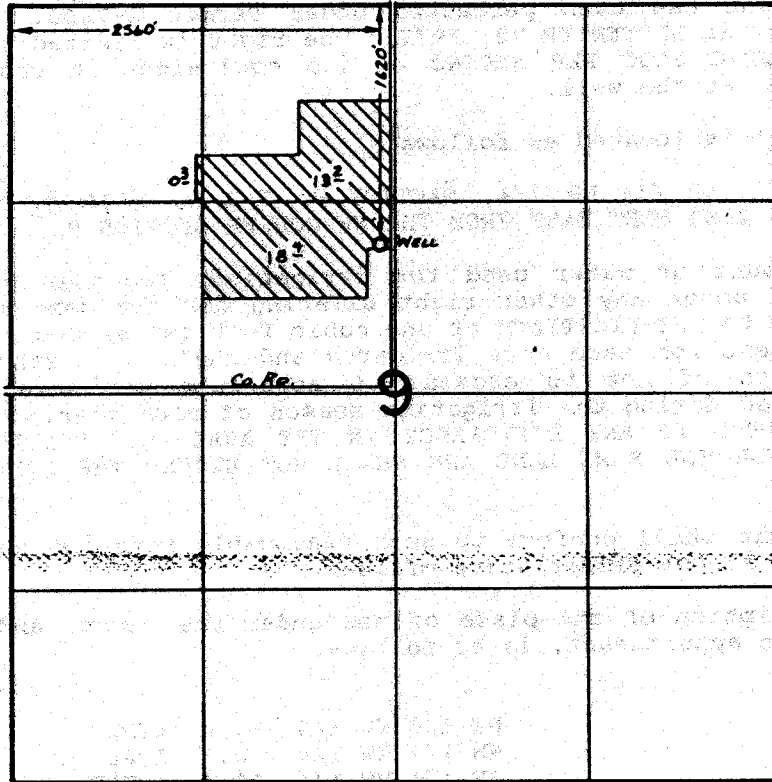

FINAL PROOF SURVEY UNDER

Application No. G-8460 Permit No. G-7600
IN NAME OF

RYAN

Surveyed Sept. 16, 1982, by L. M. TOLL