


T.15S.,R.13E.,W.M.

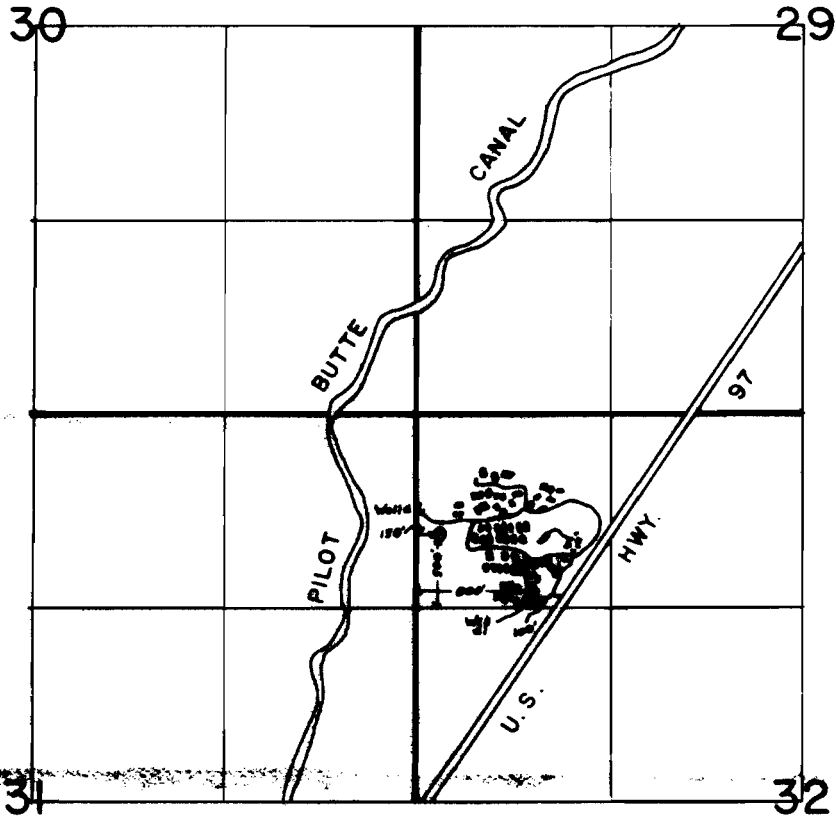

SCALE: 4" = 1 mile

FINAL PROOF SURVEY
UNDER

Application No. G-8255 Permit No. G-7603.....
IN NAME OF

DESERT TERRACE MOBILE ESTATES

Surveyed MAY 10, 1983, by L.H. NUNN.....

Cert. # 58341