


T.3S., R.38E., W. M.

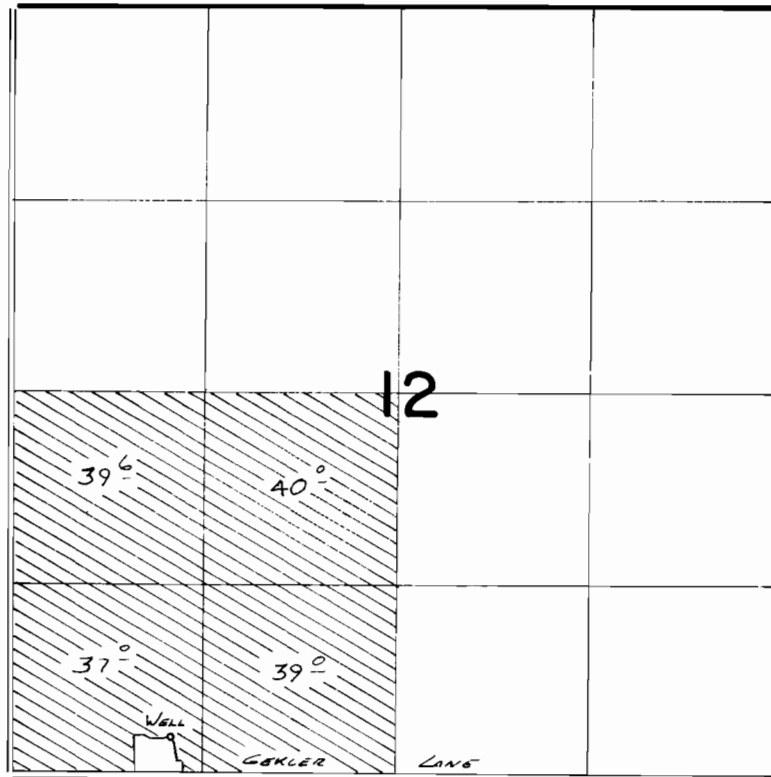

WELL LOC: 260' N. + 1100' E FROM SW COR. SEC 12

FINAL PROOF SURVEY
UNDER

Application No. **G:8174**. Permit No. **G:7625**...
IN NAME OF

.....**CRESTON J. SHAW**.....

Surveyed *Nov. 17* 198*1*, by *V. K. Church*.....