


T.1&2S.,R.39E.,W.M.

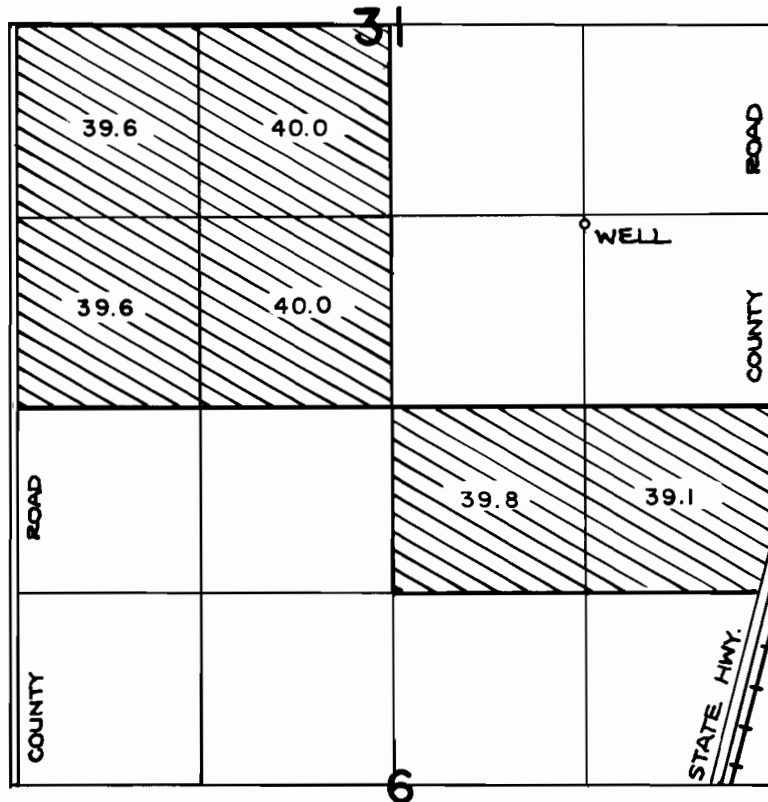

WELL IS LOCATED 1300' N. AND 1520' W.
OF THE S.E. CORNER OF SECTION 31

FINAL PROOF SURVEY
UNDER

Application No. G-8175 Permit No. G-7626
IN NAME OF

CRESTON J. SHAW

Surveyed NOV. 17, 1981, by V. CHURCH