


T. 9 S. R. 39 E. W. M.

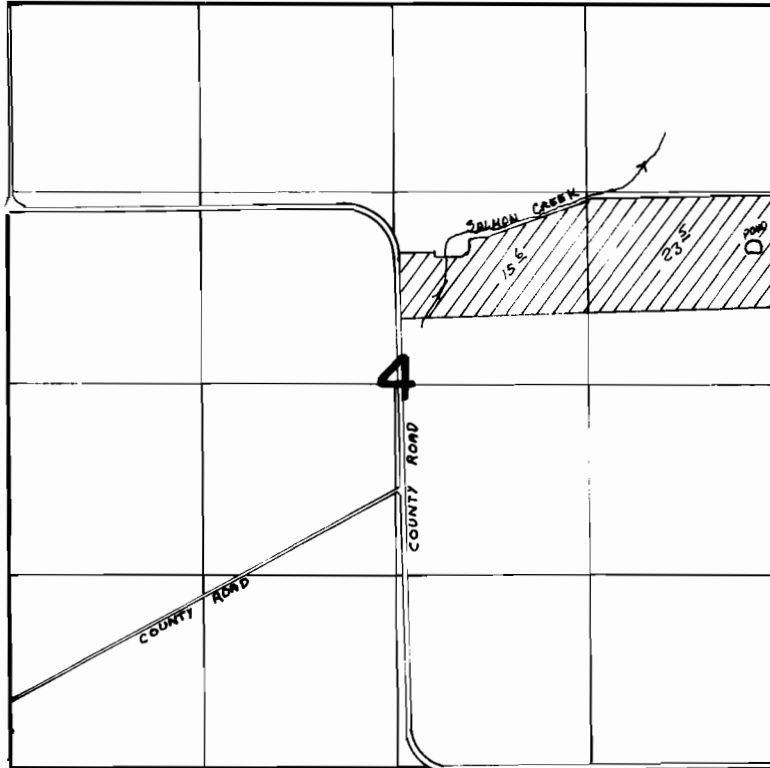

SCALE 1"=1320'



POND LOCATED 950' N. AND 150' W. FROM E. 1/4 COR. SEC. 4

FINAL PROOF SURVEY
UNDER

Application No. G-8227 Permit No. G-7628
IN NAME OF

J. CASEY HOWARD

Surveyed 8-1-1984, by Y.L. CHURCH