


T.4S. R.1E. W.M.

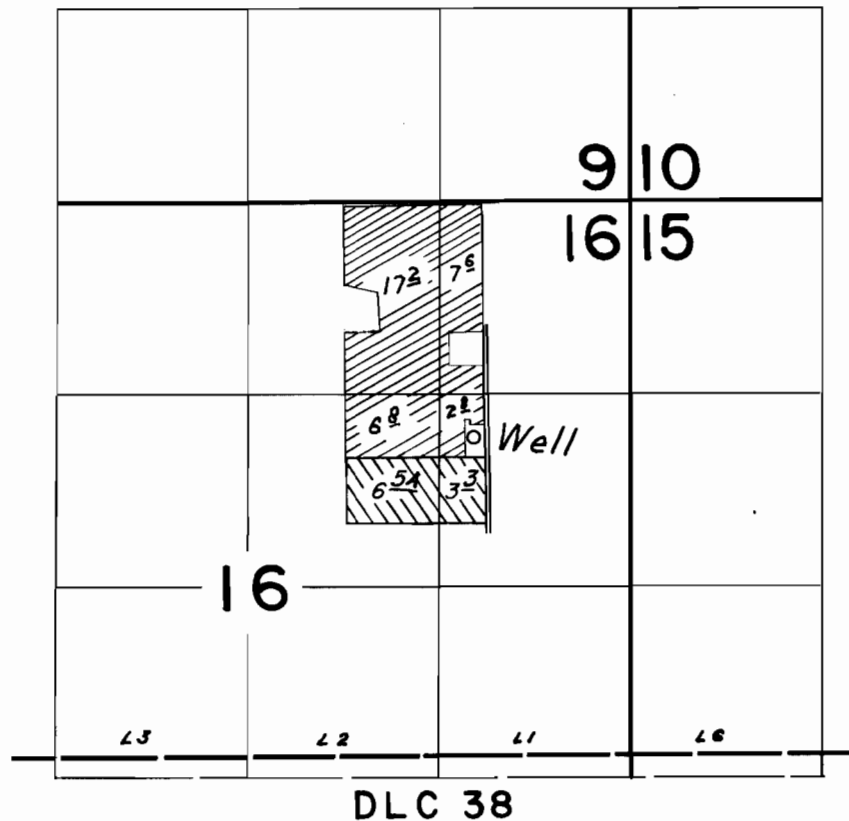

Well Loc: 1600 ft S. & 1550 ft E. from the N 1/4 Corner Sec. 16

FINAL PROOF SURVEY
UNDER

G-8214 G-7673
Application No. G-2276 Permit No. G-2104.
IN NAME OF

LEONARD JOHNSON

Surveyed Sept. 2, 1964, by C. J. Gardner
AUG. 14, 1981 *[Signature]*