


T.9S.,R.1E.,W.M.

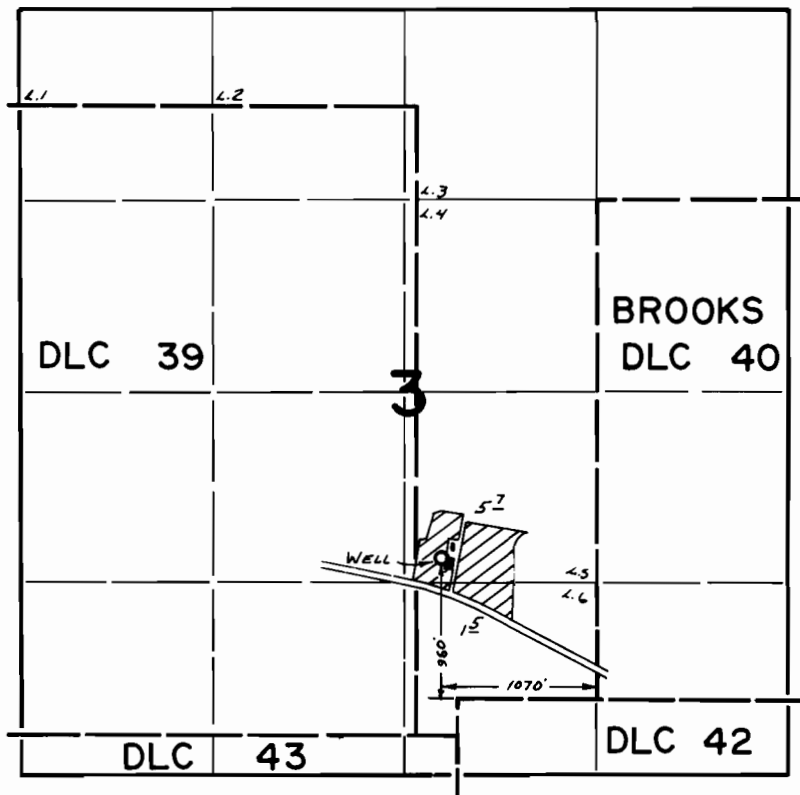

FINAL PROOF SURVEY UNDER

Application No. G-8392 Permit No. G-7784....
IN NAME OF

.....JOSEPH P. SCHMITZ.....

Surveyed Aug...4... 1981., by L.TOLL.....