


T.1S., R.3W., W.M.

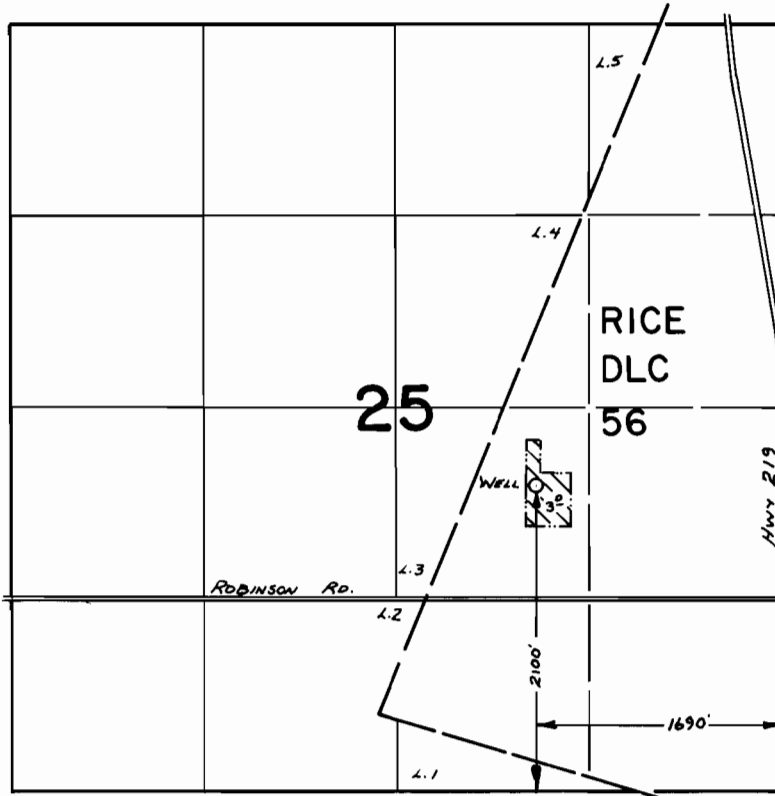

SCALE: 1" = 1320'

FINAL PROOF SURVEY
UNDER

Application No. G-8487. Permit No. G-7792.....
IN NAME OF

.....**OTIS BARBY**.....

Surveyed Nov...4... 1983., by L.M.TOLL.....