


G7821  
58349

T. 4N., R. 28E., W. M.

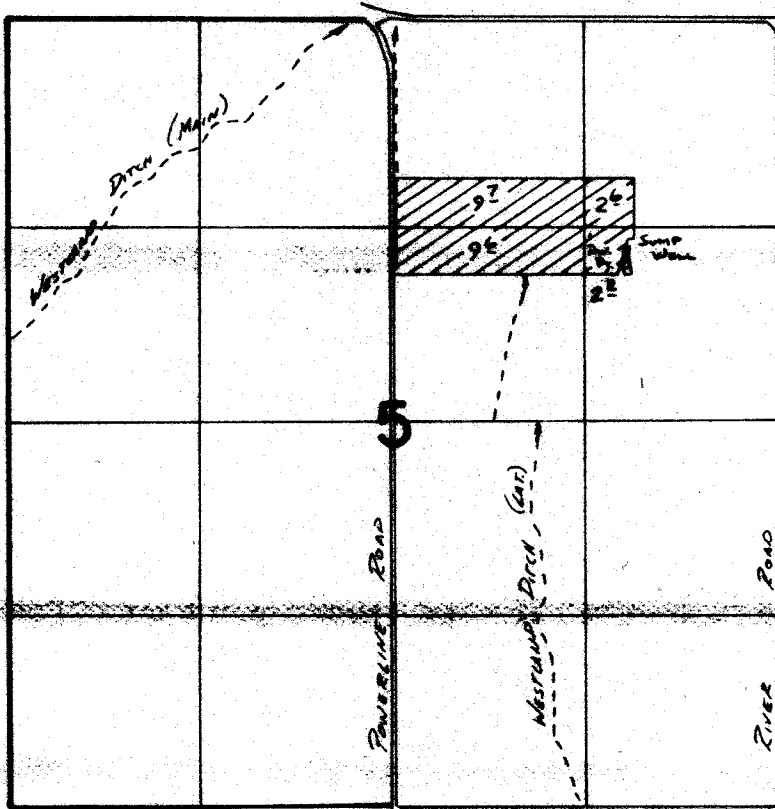

Div. Pt. Loc: 1670'S. & 1050'W. From NE COR Sec 5

**FINAL PROOF SURVEY**  
UNDER

Application No. **G-6258** Permit No. **G-7821**.....  
IN NAME OF

.....**RANDALL K. MCMICHAEL**.....

Surveyed *Aug. 18*..... 19*23*., by *W. L. Church*.....