


T.5&6S.,R.1W.,W.M.

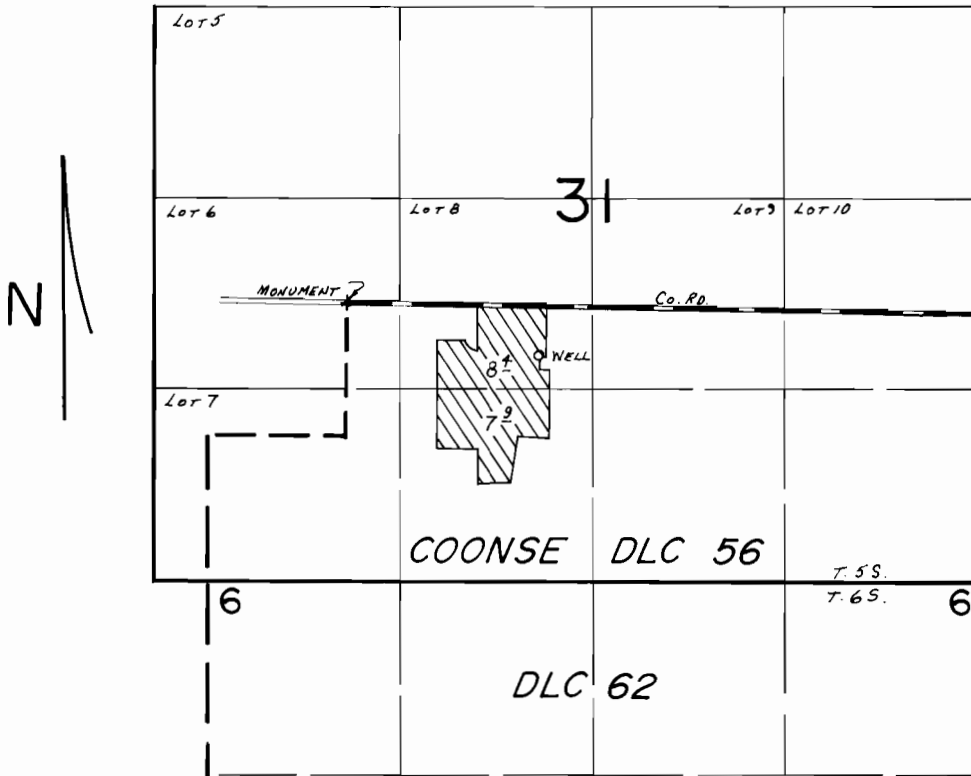

WELL LOC.: 360'S. & 1330'E. FROM MOST NORTHERLY NW COR. COONSE DLC 56.

SCALE: 1" = 1320'

FINAL PROOF SURVEY UNDER

Application No. G-8809. Permit No. G-8129.....
IN NAME OF

.....J. H. MESSER.....

Surveyed May 10, 1984, by B.W. BISHOP.....