


T. 39 S., R. 19 E., W.M.

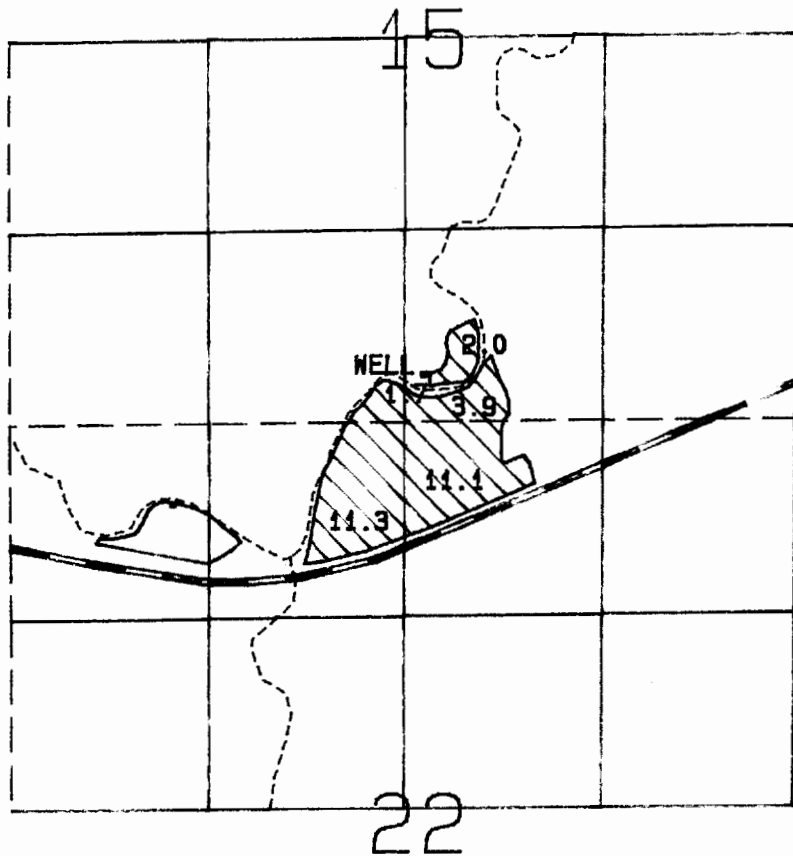

SCALE: 1" = 1320'

DIV. PT. LOCATED 350 FT. N. AND 2800 FT. E. FROM SW. SEC COR. SEC 15

FINAL PROOF SURVEY
UNDER

Application No. 6-8811 Permit No. 6-8200

IN NAME OF

Joseph M. Jaksick

Surveyed Oct. 17, 1987 By T.M. Warren
Photo: 379-89C RMK-GIS