


T.39 S., R.20 E., W.M.

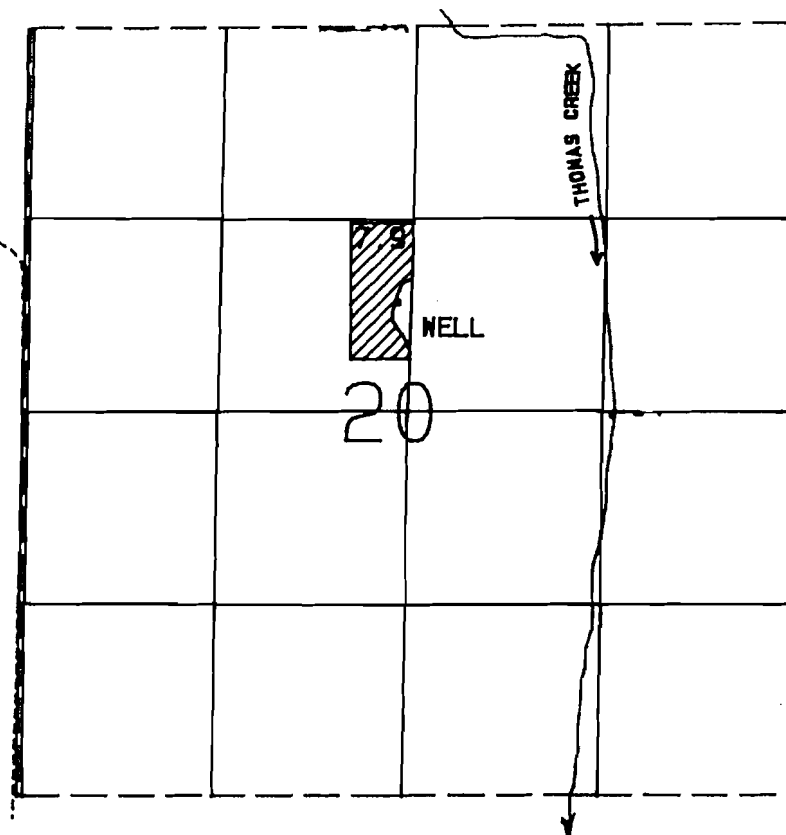

SCALE: 1" = 1320'

WELL LOCATED 1860 FT. S. AND 2560 FT. E. FROM NW. COR. SEC. 20

FINAL PROOF SURVEY
UNDER

Application No. G-11044 Permit No. G-10187

IN NAME OF

MARIAN AND JEROME PUETZ

Surveyed Oct. 15, 1987 By V.L. CHURCH

Photo: 379-70L JCL