


T. 36 S., R. 1 E., W. M.

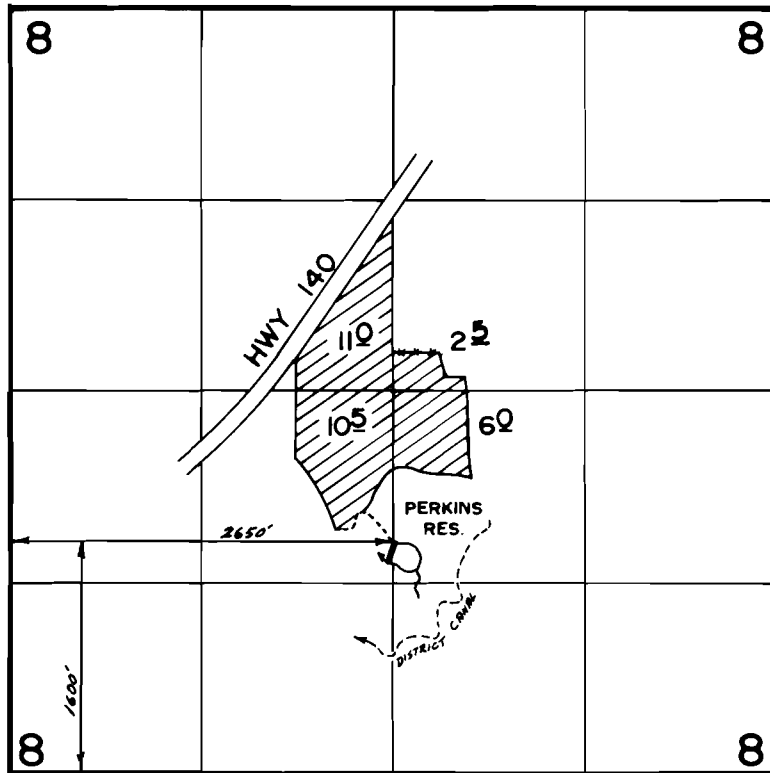

Scale 1" = 1320'



FINAL PROOF SURVEY

UNDER

R-56624

R-6726

Application No. 56625. Permit No. 42431.....

IN NAME OF

.....DENVER.....B.....PERKINS.....

Surveyed JUNE 13, 1984, by BS...JAMES.....