


T. 21 S. R. 3 W. W.M.

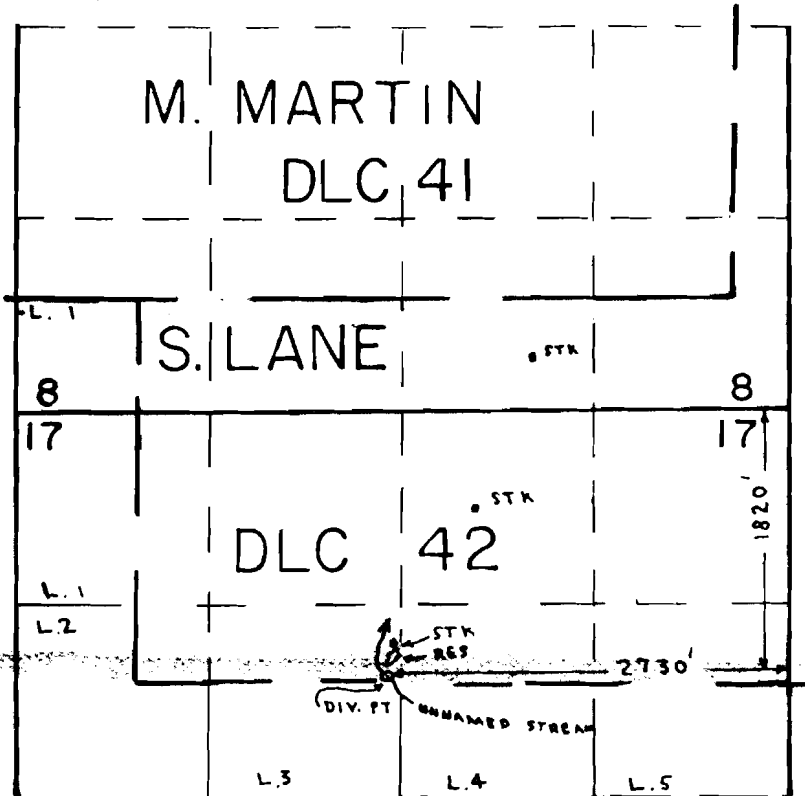

Reservoir Located: 1650 feet S. & 2650 feet W. from the
NE corner Section 17

SCALE
4" = 1 MILE

FINAL PROOF SURVEY
UNDER

R59801 R8138
Application No. 60129 Permit No. 44897.....
IN NAME OF

MAGDALENA FLENNIKEN.....

Surveyed SEPT. 26 1984, by P. PAGTER.....