


T.19S., R.4W., W.M.

SECTION 2

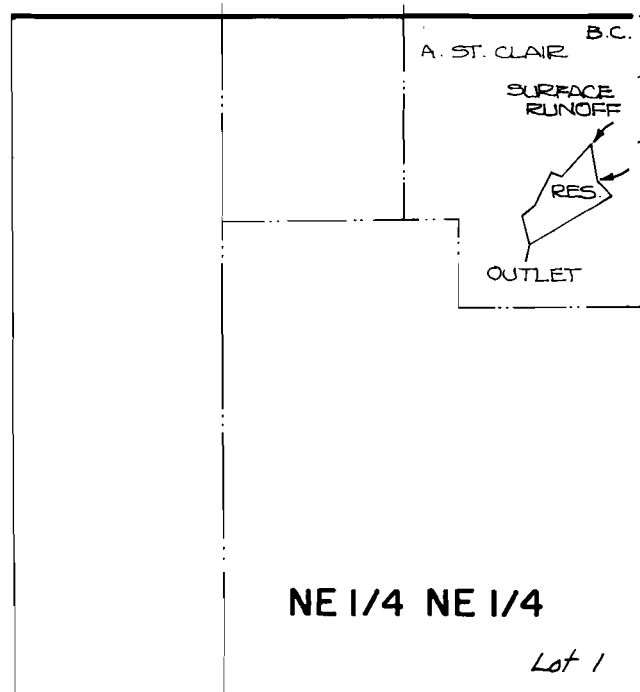

DAM LOCATION: 480 FT. S. AND 240 FT. W. FROM
THE N.E. CORNER OF SECTION 2.

SCALE: 1" = 400'

FINAL PROOF SURVEY
UNDER



R-59429 *R-8205*
Application No. *59945* Permit No. *45345*
IN NAME OF

ADRIENNE E. ST. CLAIR

Surveyed *AUG. 28, 1984*, by *P. Patten*