


T.27S., R.4W., W.M.

SECTION 31

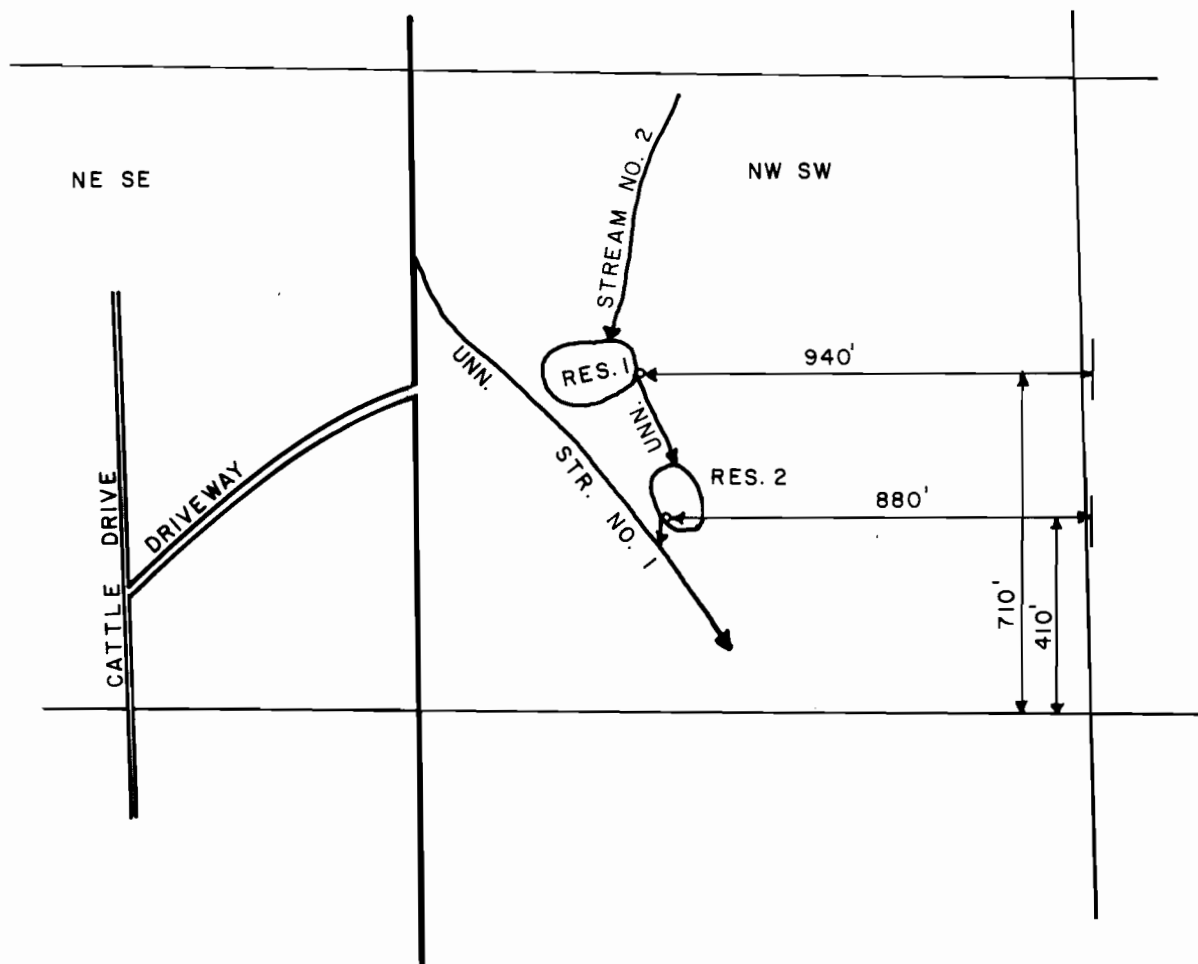

SCALE: 1" = 400'

FINAL PROOF SURVEY

UNDER

R-60614 R-8268
 Application No. 60615 Permit No. 45728
 IN NAME OF

AQDAS S. & HEATHER K. KURAISHI

Surveyed APR. 24 1986, by J. M. SCHMORDE