


T.28S. R.4W. W.M.

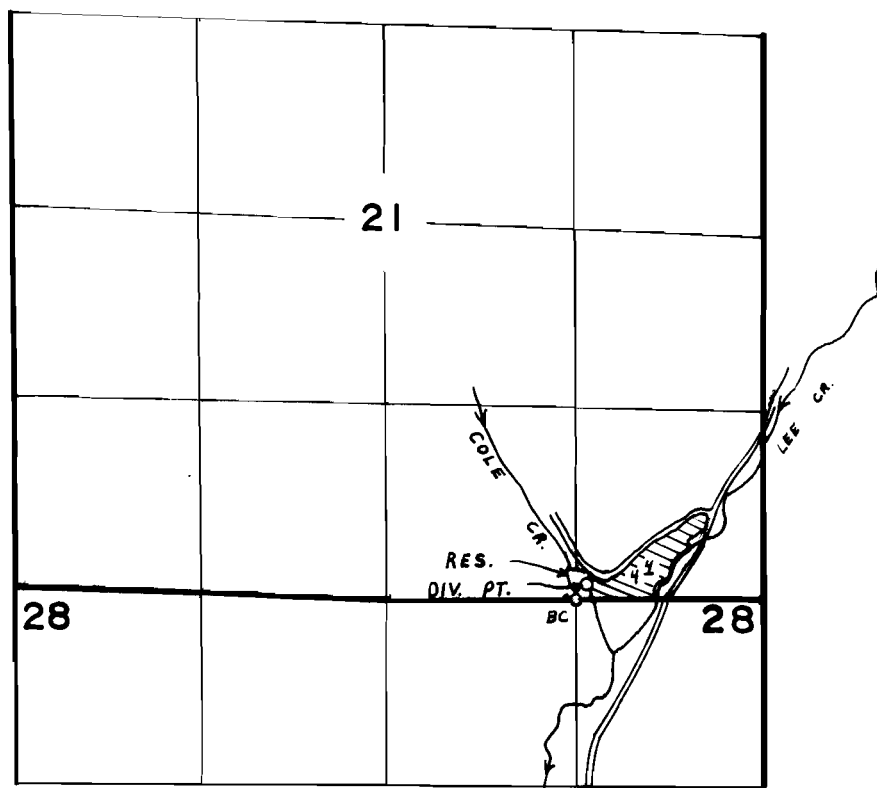

DIV. PT. IS 110' N AND 60' E OF SW CORNER
OF SE 1/4 SE 1/4 IN SEC 21

SCALE : 4" = 1 mile

FINAL PROOF SURVEY
UNDER

R-62334

R-8376

Application No. ~~62335~~.. Permit No. ~~46545~~.....

IN NAME OF

RICHARD LOCKWOOD

Surveyed SEPT. 29 1983, by *L. E. Cashion*