


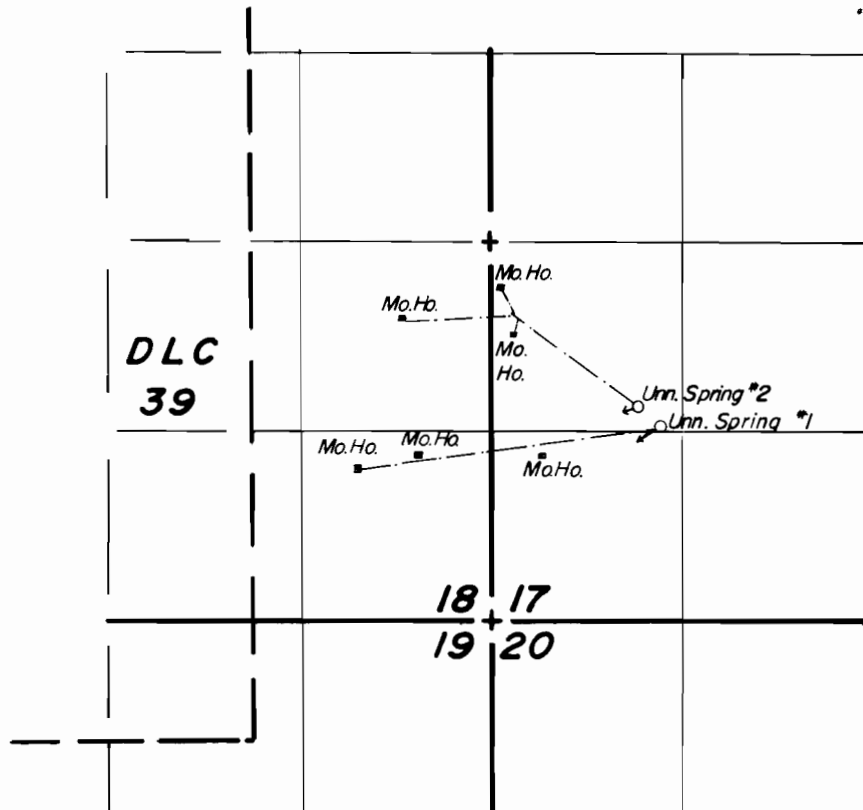

#2 Loc.: 1140' S. & 1010' E. from E. 1/4 Cor. Sec. 18.

FINAL PROOF SURVEY

UNDER

Application No. **57462**... Permit No. **43553**
57462... **43553**
IN NAME OF

WARREN DICK

Surveyed May 22, 1984, by Lynn Cashion....
May 24

BTR-1HH-259
* ZOOM SCOPE
TMW 1/14/85