


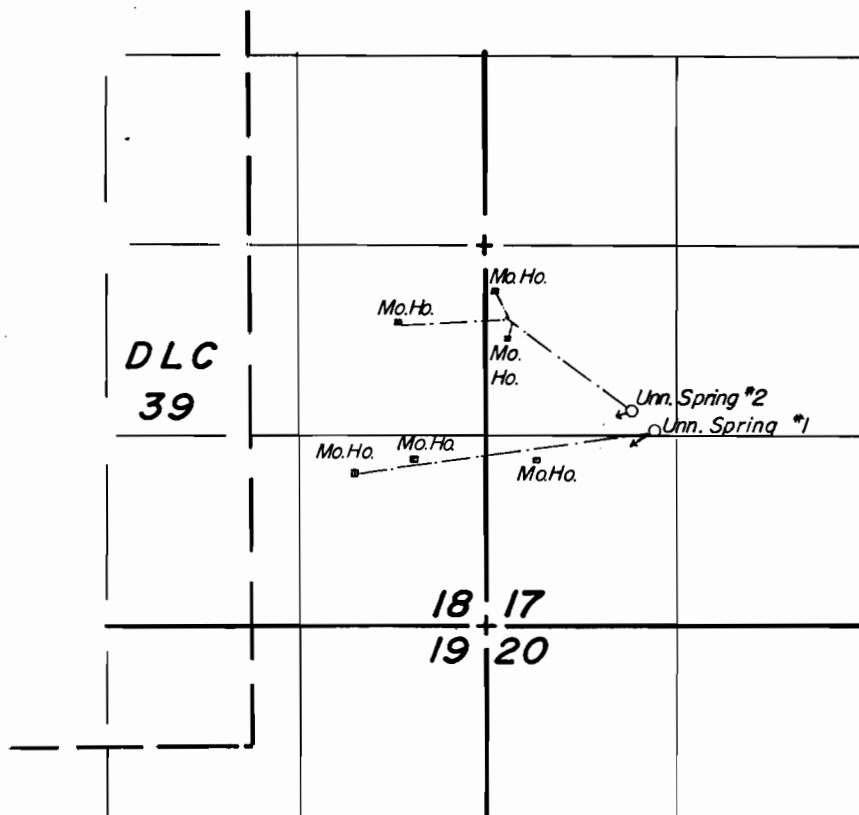

#2 Loc.: 1140' S. & 1010' E. from E. 1/4 Cor. Sec. 18.

FINAL PROOF SURVEY

WARREN DICK

BTR-1HH-259
* ZOOM SCOPE
TMW 1/14/85