



T. 33 S., R. 2 E., W. M.

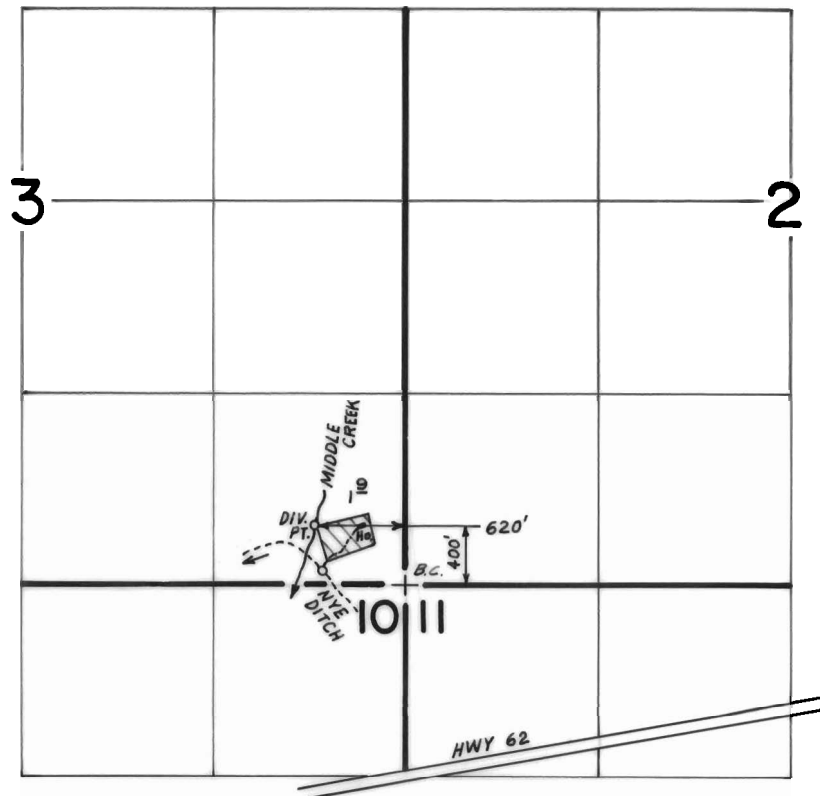

T. 32 S., R. 3 E., W. M.

Scale: 1" = 1320'

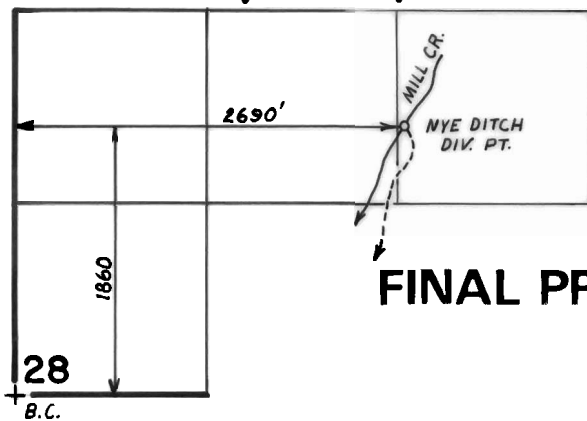

FINAL PROOF SURVEY
UNDER

Application No. **58476** Permit No. **44064**
IN NAME OF

.....**PAMELA J. WOOLMAN**.....

Surveyed **MAY 24** 19**83**, by **B.S. JAMES**.....