


T. 34 S., R. 5 W., W.M.

Sec. 24

NW 1/4 SE 1/4

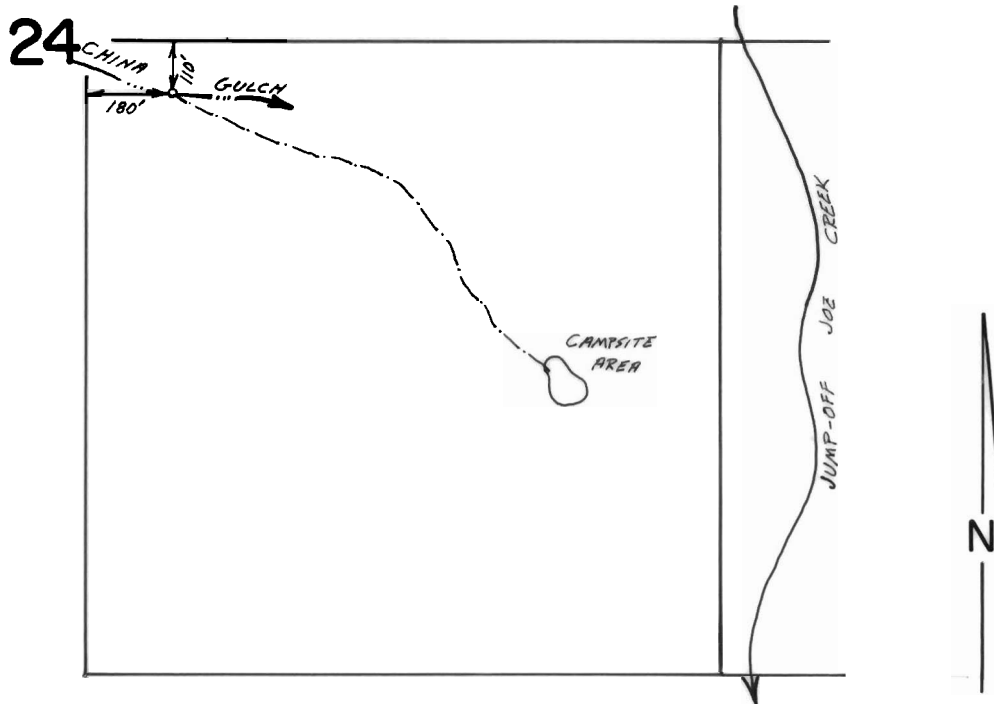

Scale 1" = 400'

FINAL PROOF SURVEY

UNDER

Application No. 59469 Permit No. 44692.....
IN NAME OF

...GARFIELD... Wm. PRIEBS.....

Surveyed Aug. 12., 1986., by B.S. JAMES.....