


T. 1 S., R. 8 W., W.M.

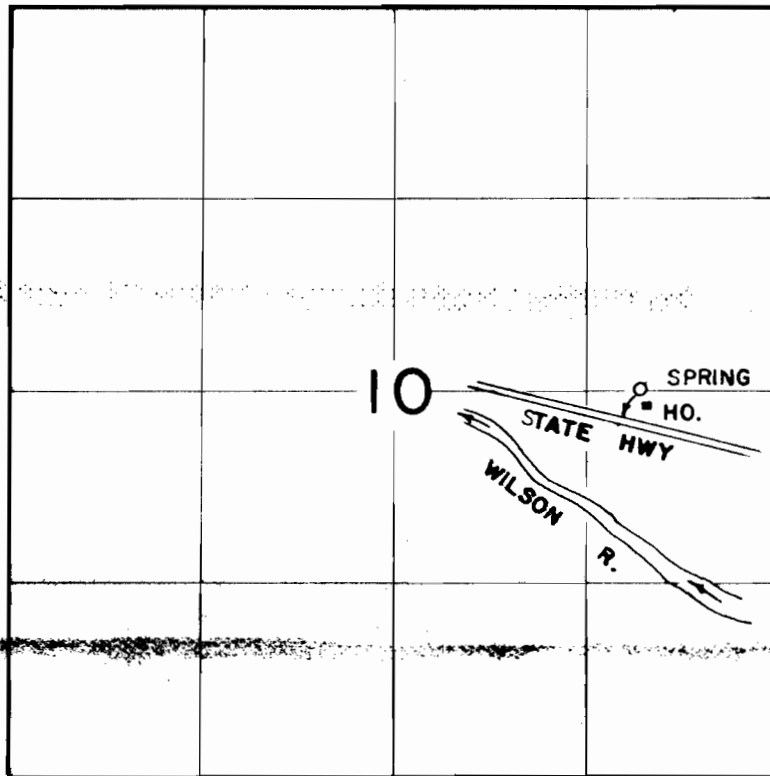

SCALE
1" = 1320'

DIV. PT. LOC. 10' N. & 960' W. OF E. 1/4 COR. SEC. 10

FINAL PROOF SURVEY
UNDER

Application No. 61560... Permit No. 45699
IN NAME OF

ROBERT G. & DOROTHY M. THOMPSON

Surveyed JUN 13, 1984, by P. PAGTER