


T. 13S., R. 9E., W.M.

SECTION 10

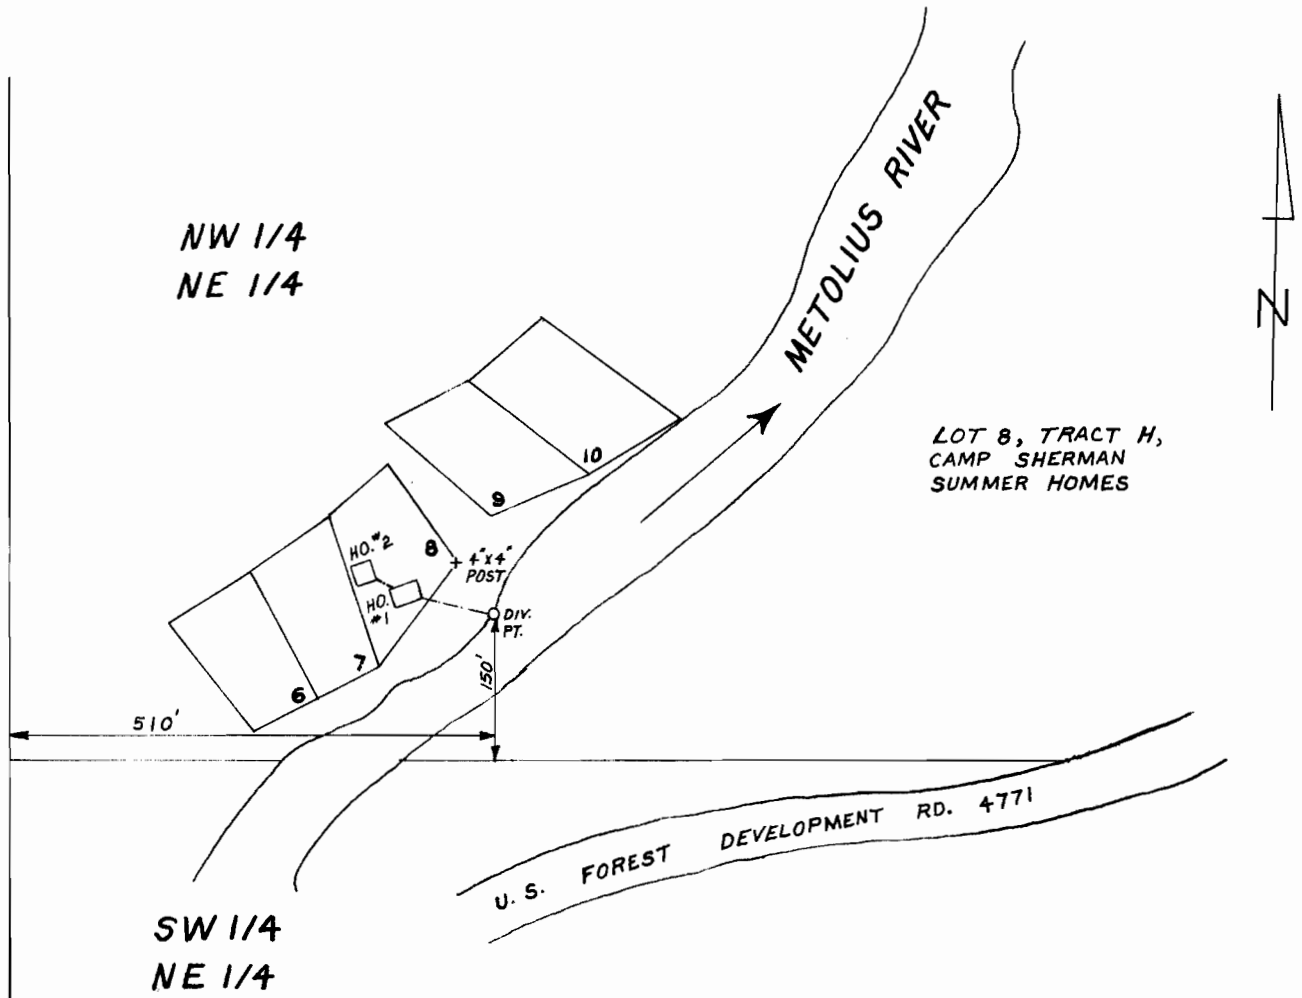

SCALE: 1" = 200'

FINAL PROOF SURVEY

UNDER

Application No. 65391 Permit No. 48064

IN NAME OF

DAVID J. & JEANNINE G. ALEXANDER

Surveyed FEB. 28, 1985, by TIM W. BURKS