


T.4S., R.3W., W.M.

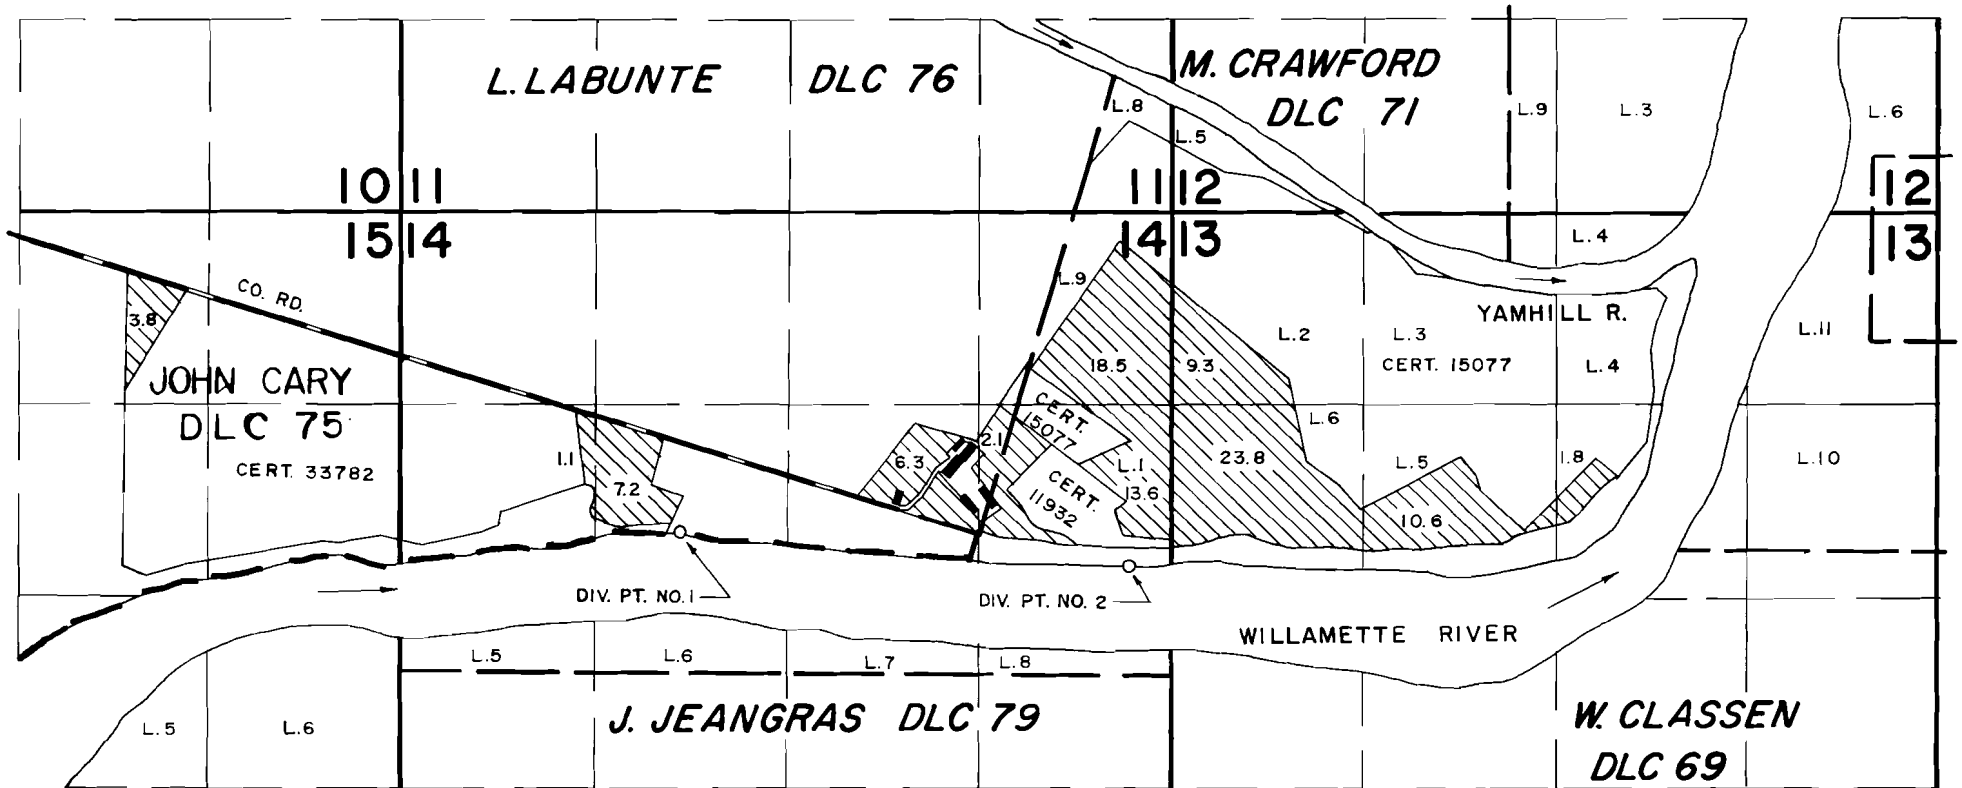

DIV. PT. NO.1 LOCATION: 40 FT. S. & 2050 FT. W.; DIV. PT. NO.2 LOCATION: 200 FT. S. & 1030 FT. E.;
 BOTH FROM THE S.E CORNER OF THE L. LABUNTE DLC 76.

FINAL PROOF SURVEY

UNDER

APPLICATION NO. 54574 PERMIT NO. 40953

IN NAME OF

BONNIEMOOR FARMS

SURVEYED MAY 31, 1984 BY *P. Pagter*

