


T.34S., R.5W., W.M.

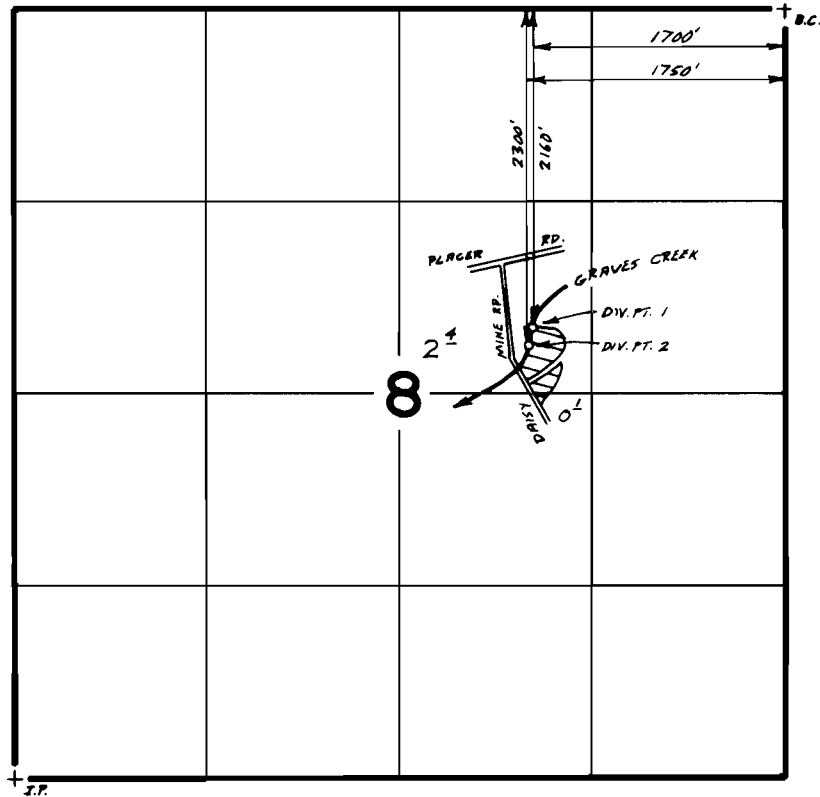

Scale 1"=1320'

**FINAL PROOF SURVEY**  
UNDER

Application No. ~~54696~~ Permit No. ~~41035~~.....  
IN NAME OF

.....**HOWARD & ALYCE COOME**.....

Surveyed ~~Aug. 13, 1986~~, by ~~B.S. JAMES~~.....