


T. 26 S., R. 6 W., W.M.

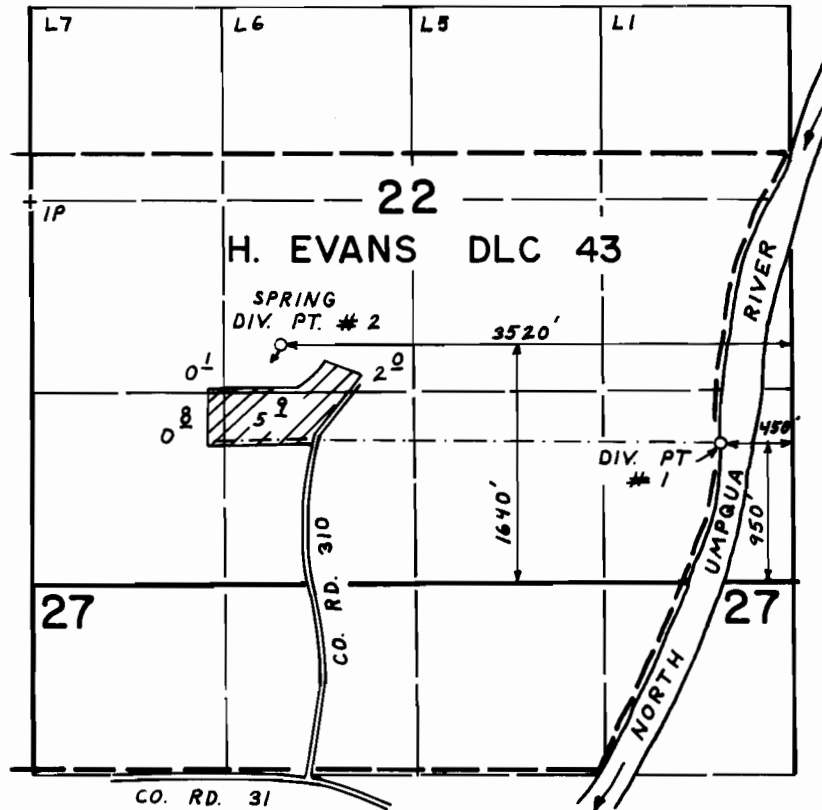

SCALE: 4" = 1 mile

FINAL PROOF SURVEY
UNDER

Application No. 56316.. Permit No. ...42388....
IN NAME OF

...SANDRA... L... WEST.....

Surveyed NOV.....8. 19.83., by *L. E. Cashion*