


T.IIS., R.IE., W.M.

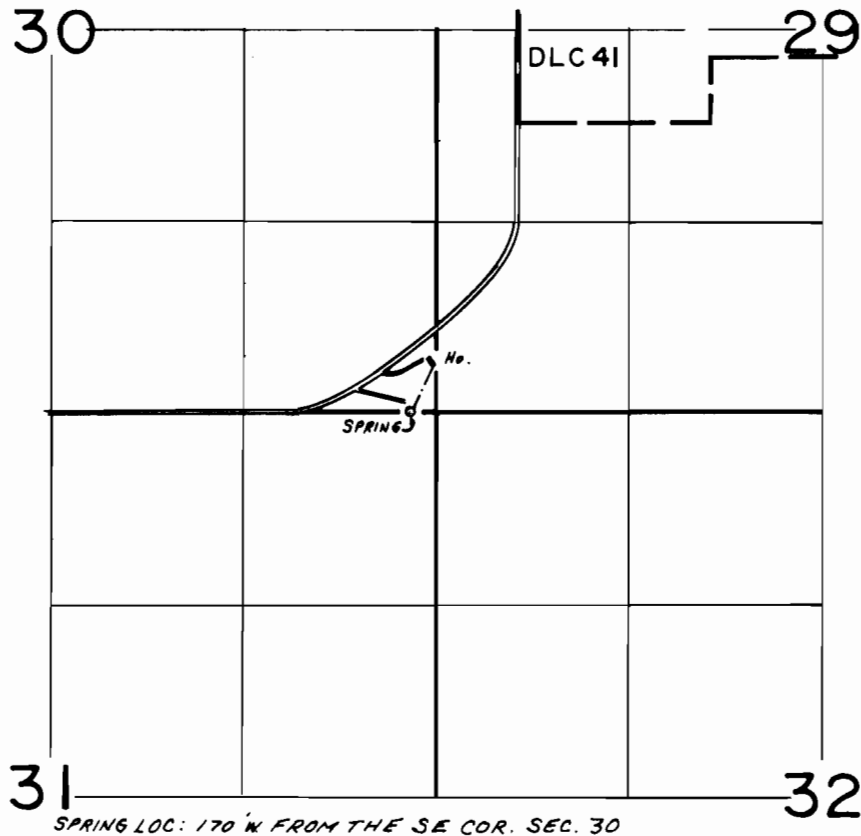

FINAL PROOF SURVEY
UNDER

Application No. 56685 Permit No. 42464....
IN NAME OF

GORDON W. BEARD

Surveyed MAY 25, 1982, by L.M. TOLL.....