T. 2 S., R. 3 W. WM.

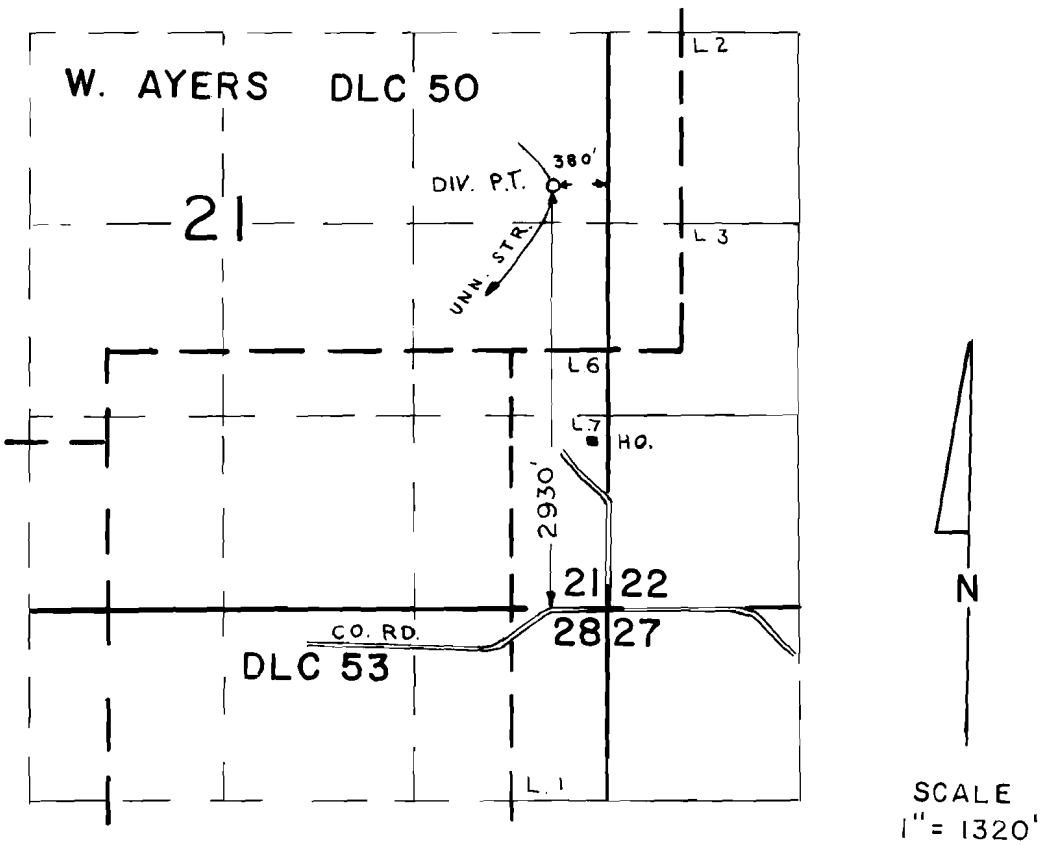

FINAL PROOF SURVEY

UNDER

Application No. 55604 Permit No. 42989

IN NAME OF

BILL D. CATHERS

Surveyed AUG 20 1984, by P. PAGTER

41071 - 178 - 135 D P.G.T.