


T.17S.,R.3E.,W.M.

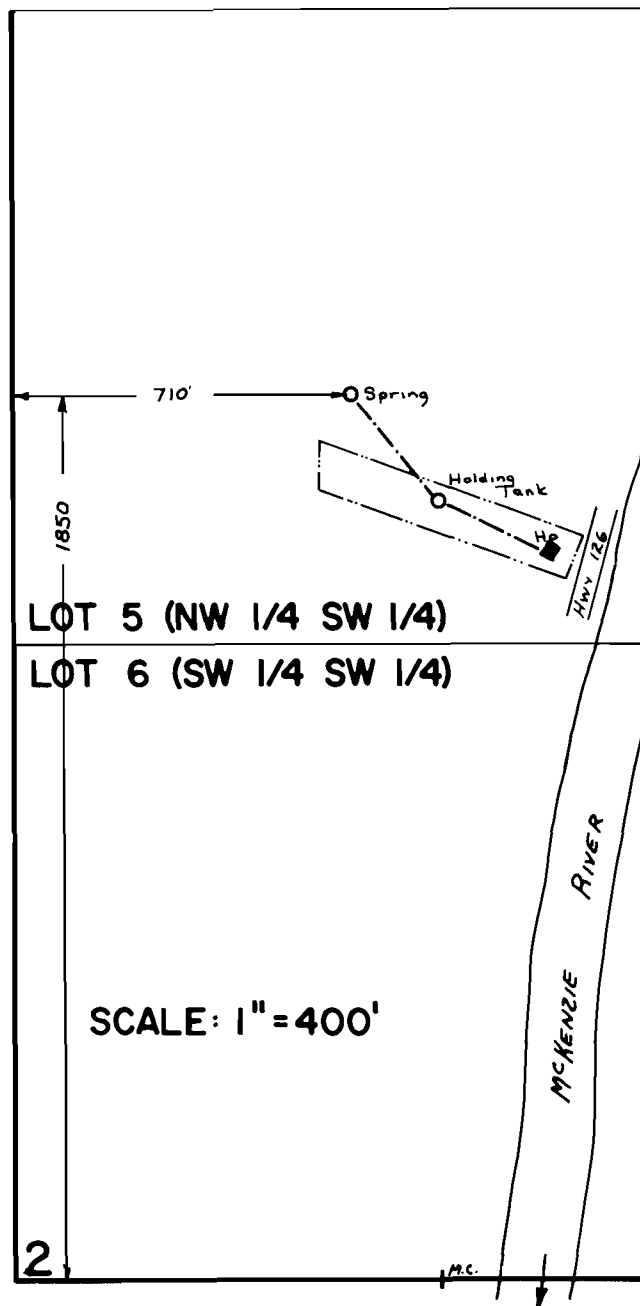

FINAL PROOF SURVEY
UNDER

Application No. 57606 Permit No. 43241
IN NAME OF

VITT & CANDY ROGACKI

Surveyed Aug. 20, 1981, by S.C. BROWN