


T.17S.,R.3E.,W.M.

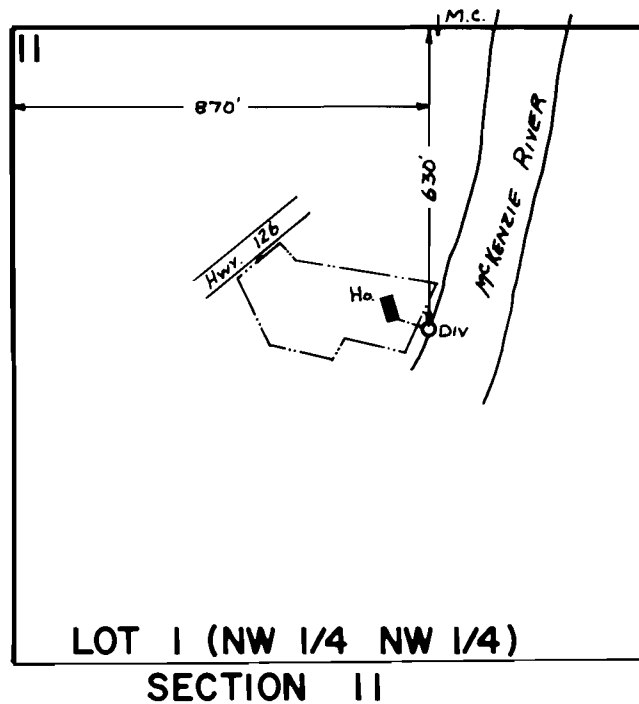

SCALE: 1"=400'

FINAL PROOF SURVEY
UNDER

Application No. 57425 Permit No. 43305.....
IN NAME OF

JOHN H. HARING

Surveyed Aug. 20, 1981, by S.C. BROWN.....