


T. 33 S., R. 7 W., W.M.

Sec. 32

SE 1/4 NE 1/4

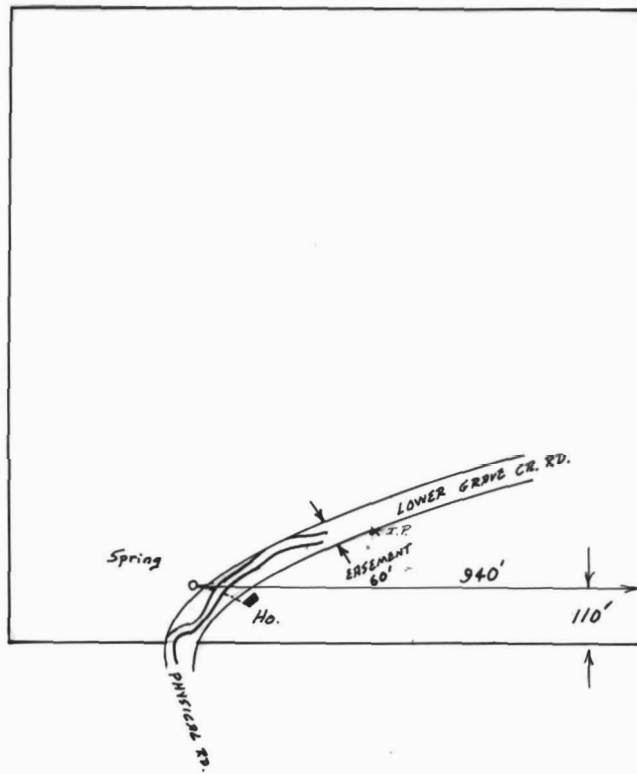

Scale 1" = 400'

FINAL PROOF SURVEY
UNDER

Application No. 57632.. Permit No. 43436.....
IN NAME OF

..... HAROLD L. COVERDALE

Surveyed Sept. 13, 1984, by J. R. WOODROOF