


T. 40 S., R. 7 W., W. M.

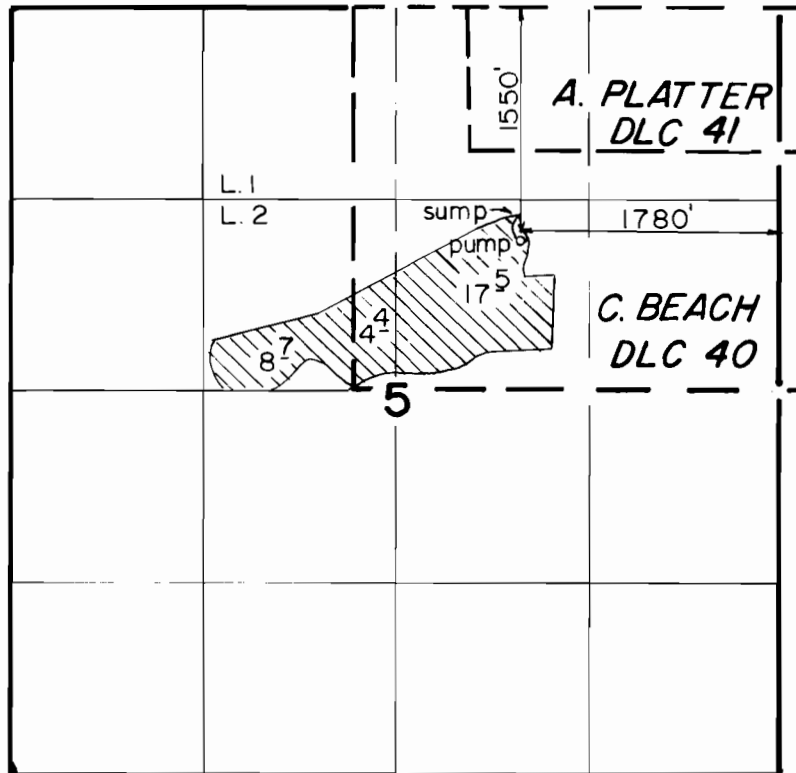

Scale: 1"=1320'

FINAL PROOF SURVEY
UNDER

Application No. G-7691 Permit No. G-7436
IN NAME OF

EDWARD LEE & MERIDETH R. (MIDDOUGH) GERBER

Surveyed MAY 12 1986, by B. S. JAMES.