


# T.17S.,R.5W.,W.M.

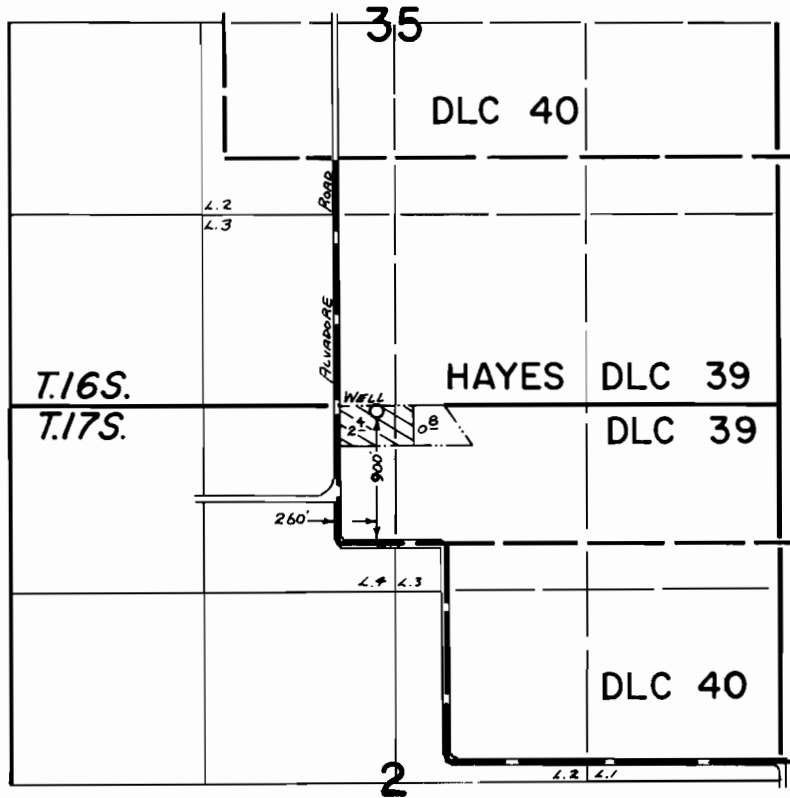

## FINAL PROOF SURVEY UNDER

Application No. G-8148. Permit No. G-7515.....  
IN NAME OF

.....**ROGER N. HEINKE**.....

Surveyed Sept. 16, 1981, by S.C. BROWN.....