


T.2N., R.12E., W.M.

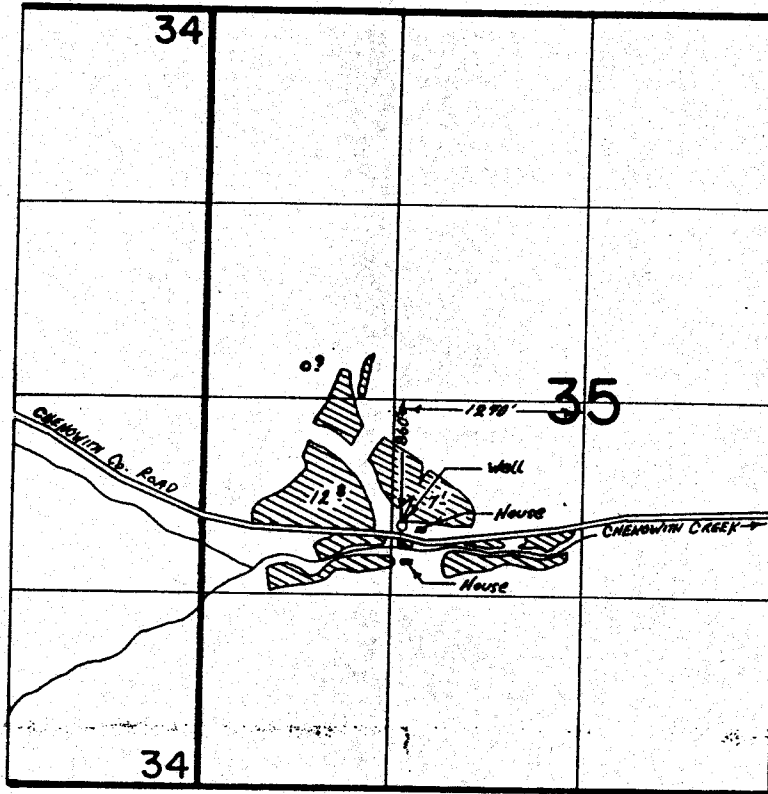

FINAL PROOF SURVEY
UNDER

Application No. G-8048 Permit No. G-7597
IN NAME OF
KETCHUM RANCH, INC. &
WILLIAM D. KETCHUM & LUCILE P. KETCHUM, TRUSTEES

Surveyed Jan. 13, 1983, by T. J. Paul