


T. 3 S. R. 40 E. W. M.

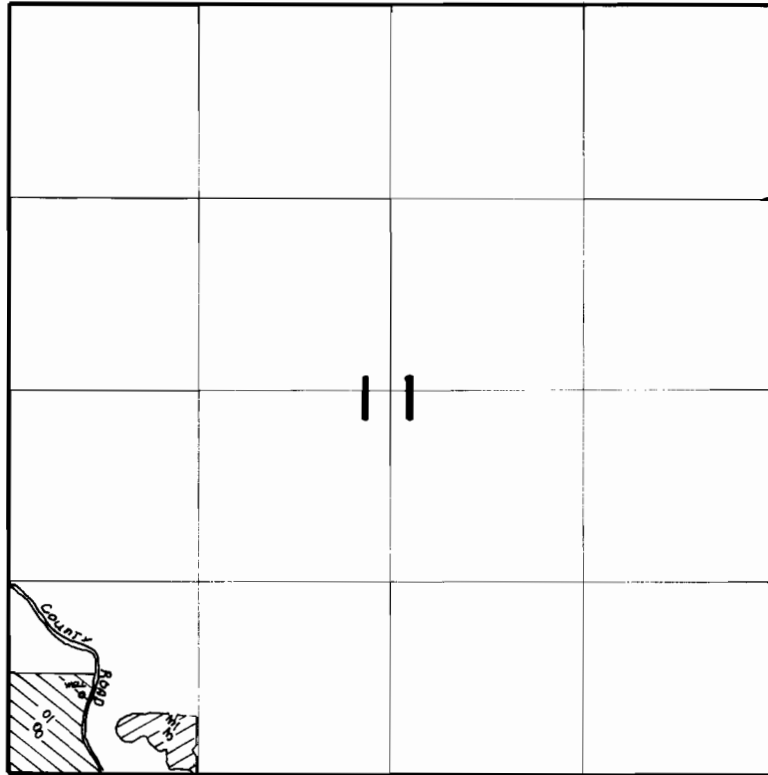

SCALE 1"=1320'



WELL LOCATED 540' N. AND 500' E. FROM S.W. COR. SEC. 11



PRIMARY



SUPPLEMENTAL

FINAL PROOF SURVEY

UNDER

Application No. G-8211.. Permit No. G-7624....
IN NAME OF

.....N.O. FITZGERALD.....

Surveyed ...7-11..... 1984., by V.L. CHURCH.....