


T. 9S., T. 39E., W. M.

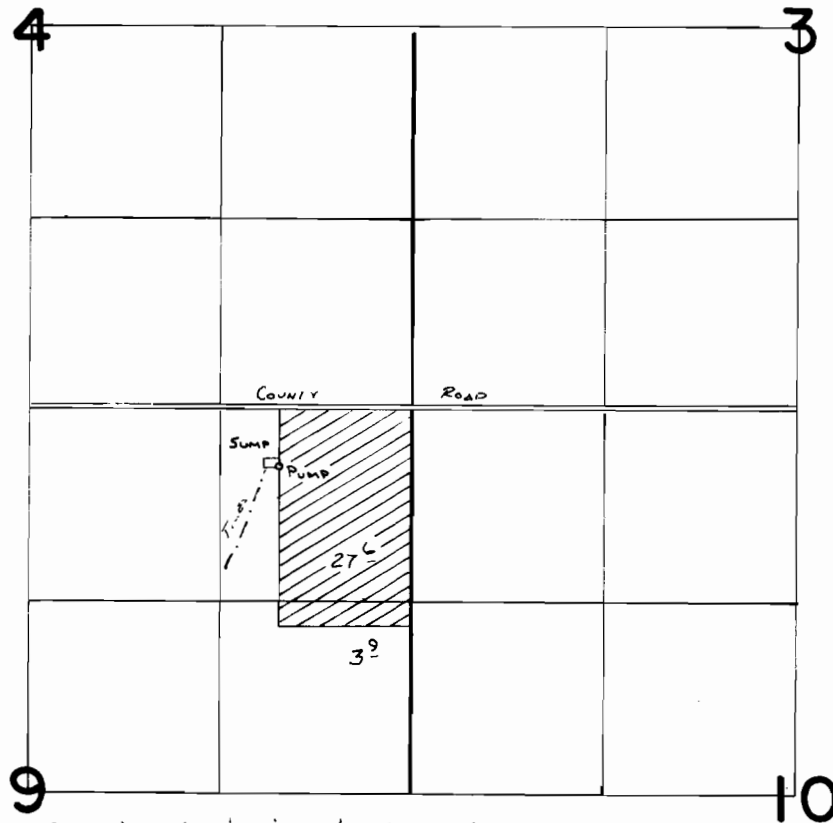

PUMP LOC: 400'S. & 910'W. FROM NE COR. SECTION 9

**FINAL PROOF SURVEY**  
UNDER

SCALE: 1" = 1320'

Application No. **G:8268** Permit No. **G:7689**...  
IN NAME OF

**LLEWELLYN L. & DARLENE E. ROBBINS**

Surveyed ...7-12... 1984, by *V.L. Church*.....