


T.3&4S.,R.IE.,W.M.

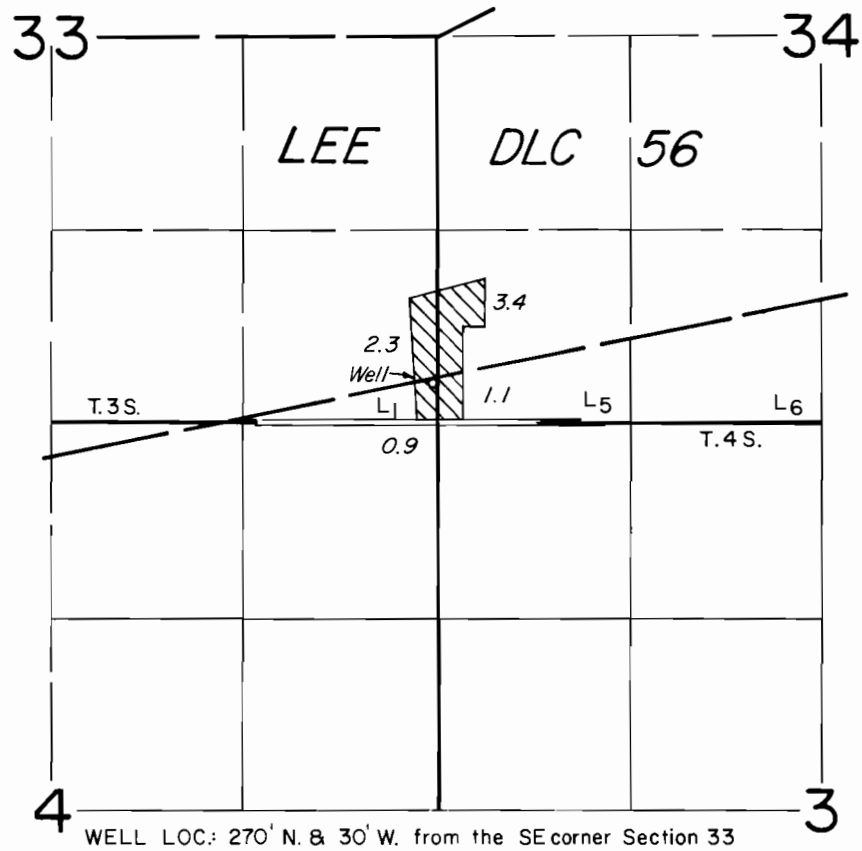

FINAL PROOF SURVEY UNDER

Application No. G-7612, Permit No. G-7780
IN NAME OF

WILLIAM OSMER

Surveyed AUG. 4, 1981, by *Al Braun*