


T. 2S., R. 38E., W.M.

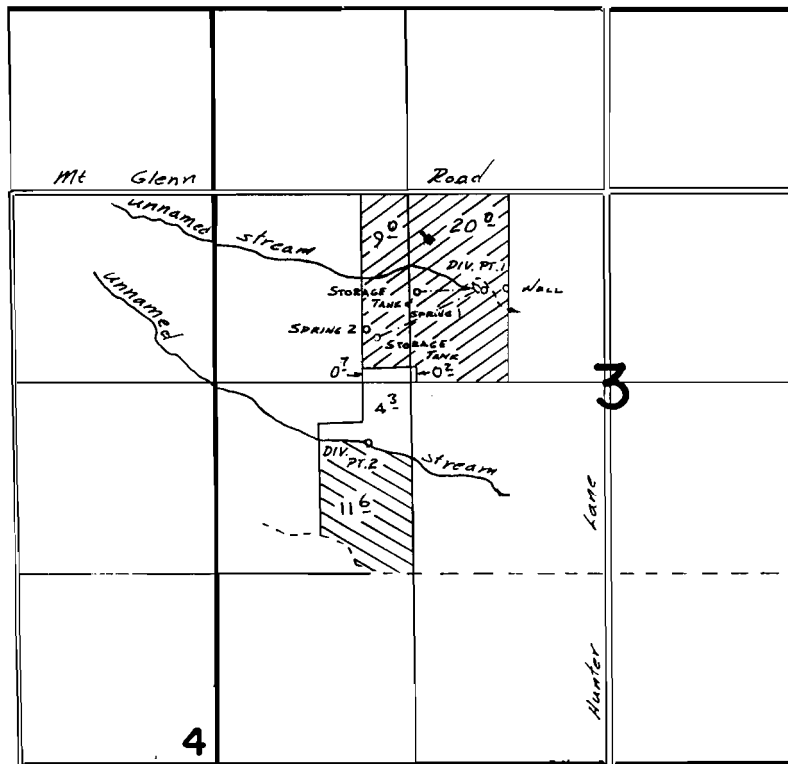

Unnamed Stream Loc: 410'S. & 1050'E. From W¼ Cor. Sec. 3 (Div Pt. 2)

Spring 1 Loc: 620'N. & 1390'E. From W¼ Cor. Sec. 3

Spring 2 Loc: 360'N. & 1040'E. From W¼ Cor. Sec. 3

Well 1 Loc: 650'N. & 2000'E From W¼ Cor. Sec. 3

 Spring 1 & 2

 Well

 Div. Pt. 2

FINAL PROOF SURVEY UNDER

G-8626

G-7916

Application No. 53890 Permit No. 40458

IN NAME OF

JOHN SCOTT HARVEY

Surveyed Aug. 23 1983, by R.L. Church