


T. 2S., R. 38E., W.M.

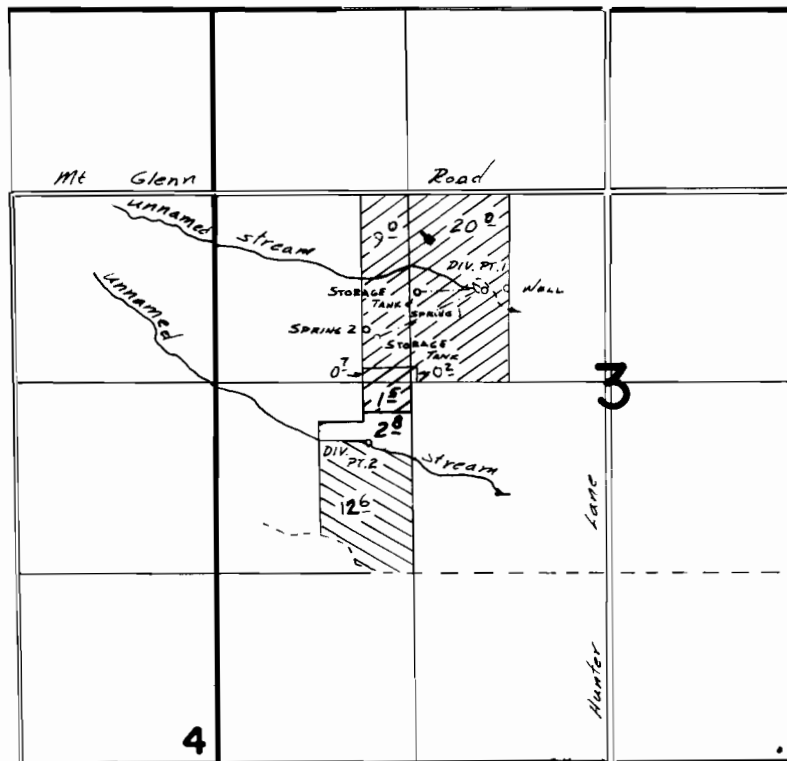

Unnamed Stream Loc: 410'S. & 1050'E. From W $\frac{1}{4}$ Cor. Sec. 3 (Div Pt. 2)

Spring 1 Loc: 620'N. & 1390'E. From W $\frac{1}{4}$ Cor. Sec. 3

Spring 2 Loc: 360'N. & 1040'E. From W $\frac{1}{4}$ Cor. Sec. 3

WELL 1 Loc: 650'N. & 2000'E From W $\frac{1}{4}$ Cor. Sec. 3

FINAL PROOF SURVEY
UNDER

 Spring 1 & 2

 Well

 Div. Pt. 2

G-8626

G-7916

Application No. 53890 Permit No. 40458

IN NAME OF

JOHN SCOTT HARVEY

Surveyed Aug. 23, 1983, by J. L. Church