


T.26S., R.15E., W.M.

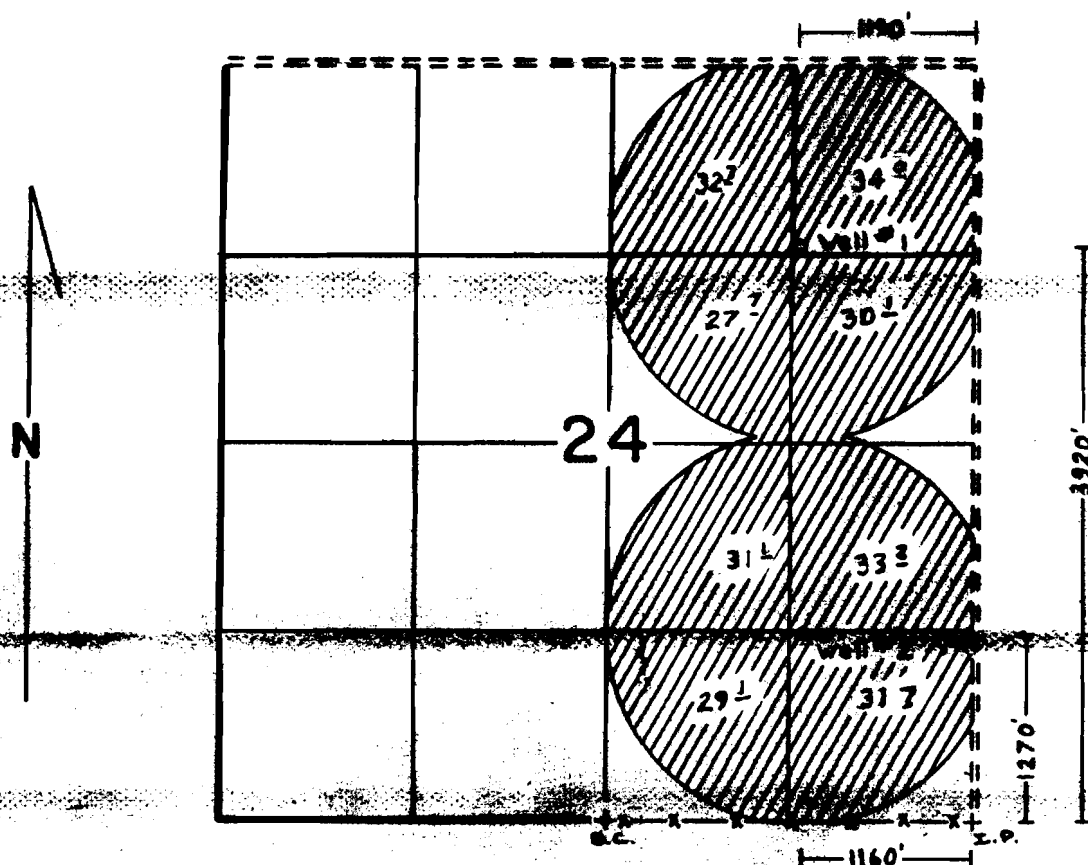

FINAL PROOF SURVEY
UNDER

Application No. G-8783. Permit No. G-8134.....
IN NAME OF

CODY J. PORTERFIELD

Surveyed JUNE 19, 1985, by LESLIE OLSON.....