


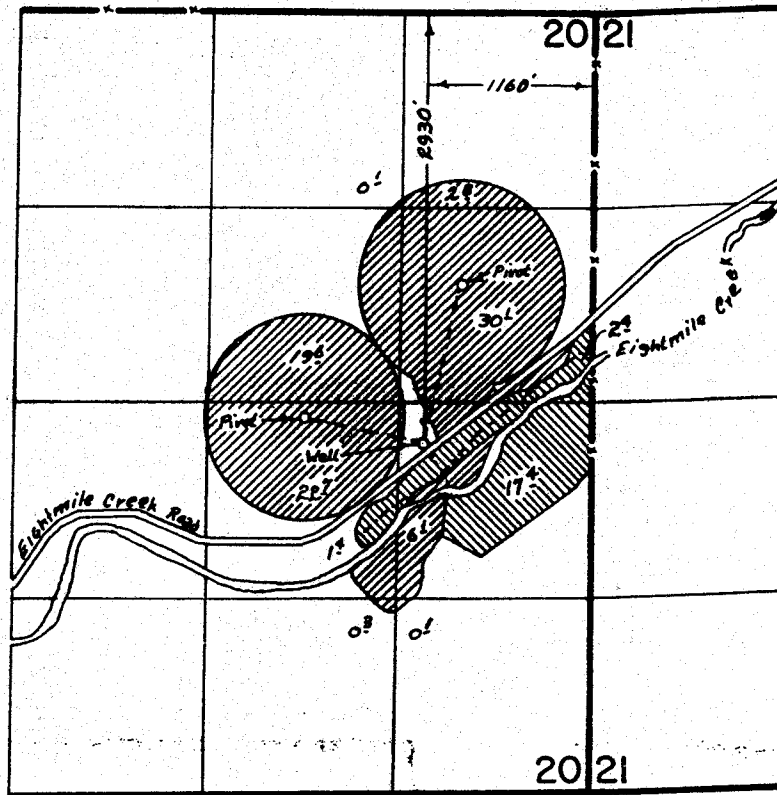

T.1S., R.13E., W.M.



 Primary
 Supplemental

FINAL PROOF SURVEY
UNDER

Application No. G-8078 Permit No. G-8156
IN NAME OF

MILLER RANCH COMPANY

Surveyed Jan. 14, 1983, by T. J. Paul