


T. 4S., R. 2W., W.M.

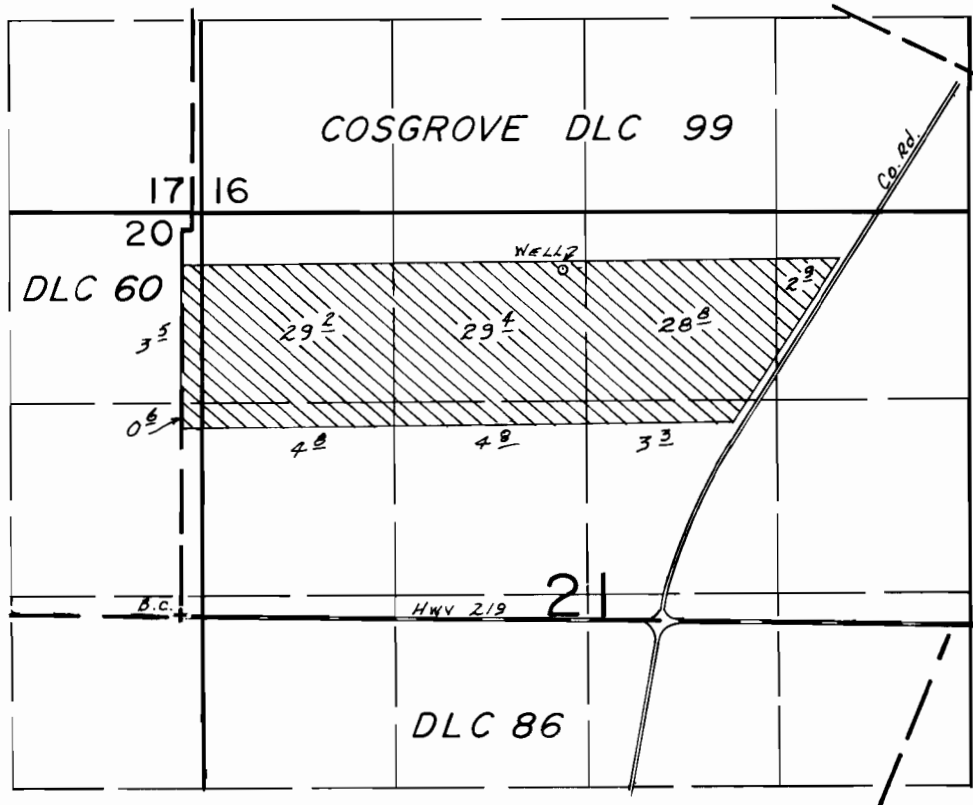

WELL LOC: 2380' N. & 2620' E. FROM SW CORNER COSGROVE DLC 99

FINAL PROOF SURVEY
UNDER

Application No. G-8827. Permit No. G-8174.....
IN NAME OF

.....EDWARD T. BRENTANO.....

Surveyed Sept...7.... 19.83, by L.M.TOLL.....