


G-9117
58413

T.40 S., R.20 E., W.M.

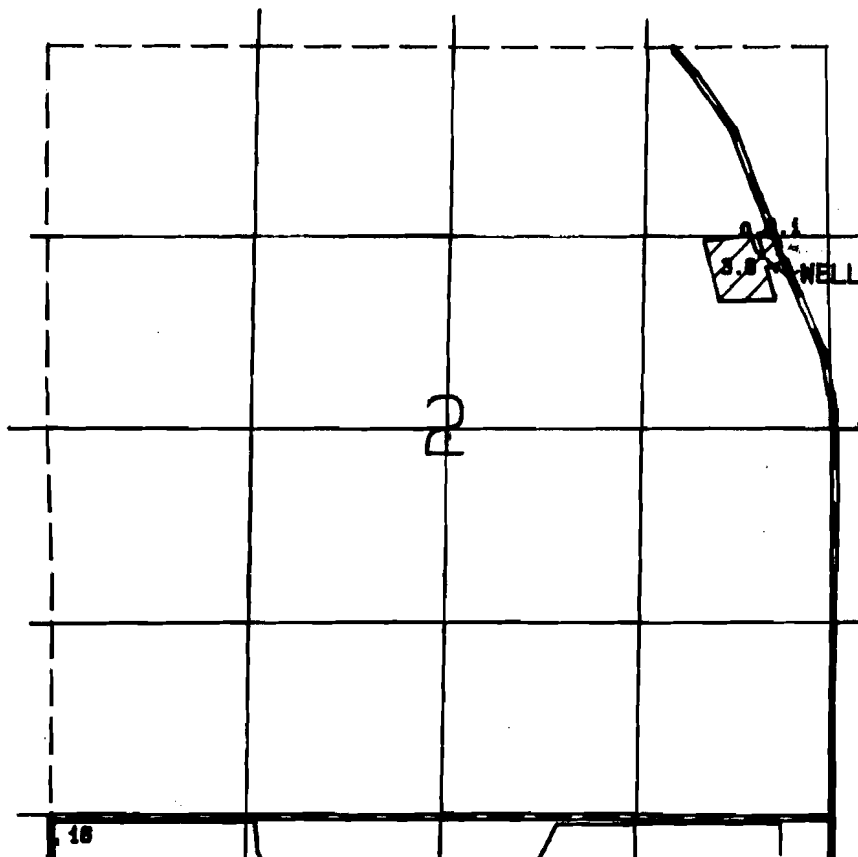

SCALE: 1" = 1320'

WELL LOCATED: 385 FT. N. AND 490 FT. W. FROM SE. COR. SEC. 2

FINAL PROOF SURVEY
UNDER

APPLICATION NO. 6-9700 PERMIT NO. 6-9117

IN NAME OF

FRANCIS M. MCNELEY

Surveyed Oct. 15, 1987 By V.L. CHURCH

Photo: 379-167D JCL